IREDELL COUNTY HEALTH DEPARTMENT

STATESVILLE 704-878-5305 MOORESVILLE 704-664-5281

IMPROVEMENT PERMIT / CERTIFICATE OF COMPLETION / OPERATION PERMIT / EXISTING SYSTEM INSPECTION

PROPERTY DESCRIPTION NO. 23467 DATE 4-23-96 TAX MAP NO. 5B-2-A-21 Watershed: ☐ Yes ☒ No

OWNER OR CONTRACTOR Ernest Bunge PHONE: Business Home 872 6642

ADDRESS 314 Long Island Rd Statesville

LOCATION 64E TR New Salem Ch Rd TL Salem meadows Dr. 3rd lot Rt DESIGN FLOW 360 L.T.A.R. .22

SUBDIVISION Salem meadows BLOCK / SECTION LOT 21 LOT AREA 1.66 acres SITE CLASS PS

Septic Tank: 1000 Gallons; STB 1012 Date 8-24-96

Pump Tank: Gallons; PT Date

Pump Make: Model Serial No.

Nitrification Field: No Fields 1 Square Feet 1200 Linear Feet 400

No Lines 4 Trench Width 36" Max Trench Bottom Depth 36" Gravel Depth N/A

☒ New System ☐ Repair System Type: I. II. III. IV. V. VI

System Description: Gravity chambers

Repair System Description: Pump To Chambers

Maintenance Agreement Required: ☐ Yes ☒ No

☐ House/Mod. Home ☐ Mobile Home ☐ Business ☐ Other

No. Bedrooms 3 No. Bathrooms 2 No. Employees


☐ Slab ☒ Crawl Space ☐ Basement w/plumbing ☐ Basement wo/plumbing

Water Supply: ☐ Individual ☐ Community ☒ Public

Comments:

Comments:

INITIAL SITE SKETCH

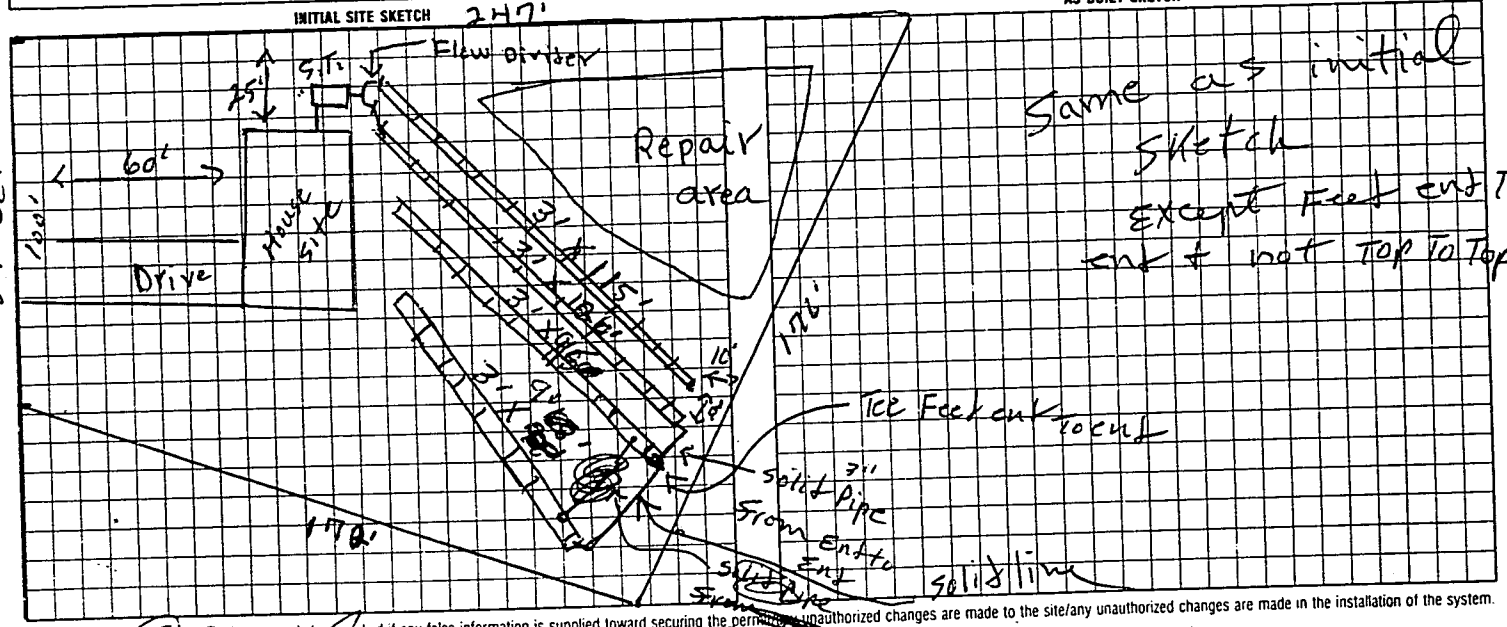

AS BUILT SKETCH

Same as initial Sketch Except Feet end To end not Top To Top

I understand that this Permit can be suspended or revoked if any false information is supplied toward securing the permit or unauthorized changes are made to the site/any unauthorized changes are made in the installation of the system.

Signed:

Improvement Permit by: R.C. Moore date 4-23-96

Existing System Inspection by: R.C. Moore date 4-23-96 authorization to count

Installed by: Tommy Frye date

Certificate of Completion by: date

Operation Permit by: R.C. Moore date 11-25-96 EXPIRES 60 mos From issue

HLTH DEPT. COPY: WHITE INSPECTION COPY (FINAL): GREEN OWNER COPY (FINAL): YELLOW INSPECTION COPY (INITIAL): PINK OWNER COPY (INITIAL): GOLD

002067