IREDELL COUNTY HEALTH DEPARTMENT - *ENVIRONMENTAL HEALTH* ☐ STATESVILLE OFFICE 704-878-5305 ☐ MOORESVILLE OFFICE 704-664-5281

IMPROVEMENT PERMIT / AUTHORIZATION TO CONSTRUCT / OPERATION PERMIT / EXISTING SYSTEM INSPECTION

PERMIT # 165 918 PIN # 4774-21-8810 DATE 11 MAY 2011

OWNER Alvin Pettit APPLICANT: PHONE: Home/Cell # 704-902-0799 Business #

SITE ADDRESS Primrose LN. Statesville OWNER / APPLICANT ADDRESS

SITE DIRECTIONS Hwy 64 E TR New Salem Rd. TR Primrose LN. GO TO END

SUBDIVISION BLOCK / SECTION LOT # LOT AREA 11 Ac. DESIGN FLOW 360 gpd L.T.A.R. 0.3 g/ft²d

Septic Tank 1000g Gallons: STB 1012 Date 4-7-11
Pump Tank Gallons: P T Date
Pump Make Model Serial #
No. Nitrification Fields: 1 No. Lines 4 Linear Feet 300
Trench Width 36" Max. Trench Bottom Depth 36" Gravel Depth PA

☑ New System ☐ Repair ☐ Expansion System Type I II (III) IV V VI
System Description: 25% Reduction
Repair System Description: 25% Reduction
Maintenance Agreement Required ☐ YES ☑ NO
☑ GRAVITY ☐ PRESSURE


☑ Residence No. Bedrooms 3
☐ Business No. Persons
☐ Other No. Employees
☐ Slab ☐ Crawl Space
☑ Basement w/plumbing ☐ Basement w/o plumbing

Water Supply: ☑ Private ☐ Public ☐ Community


Comments / Conditions: Follow CONTOUR

Poly/Rock Filter
ST MARKER

INITIAL SITE SKETCH

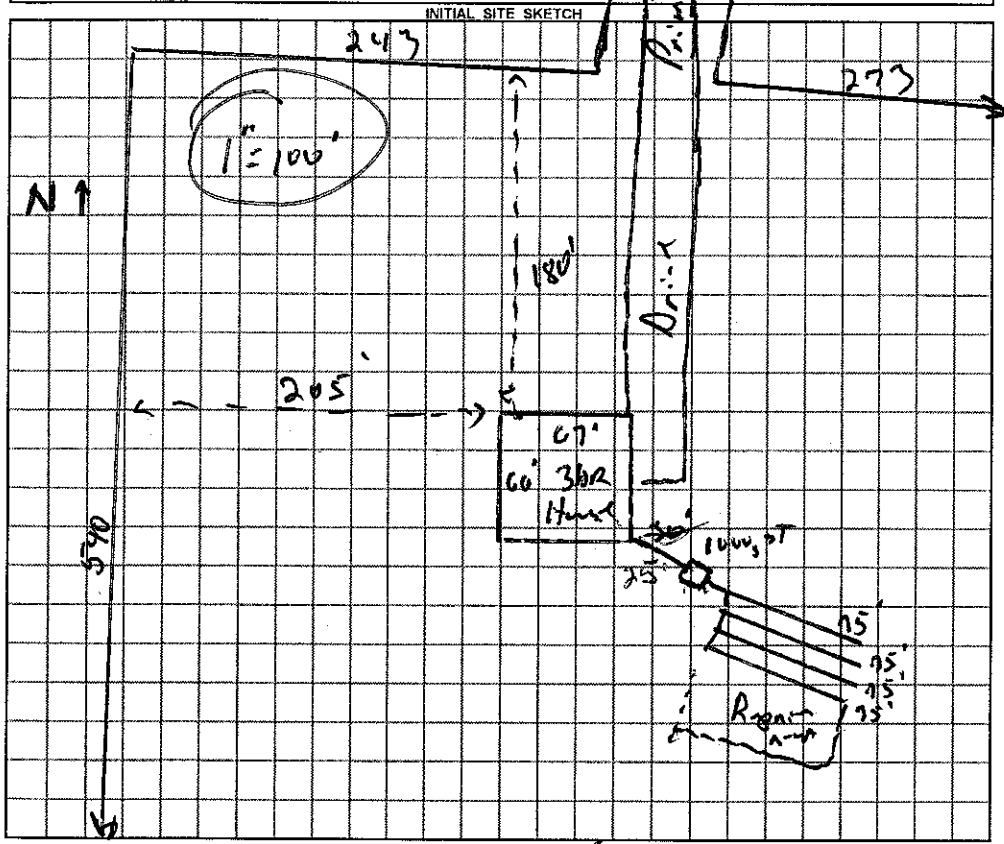

AS BUILT SKETCH

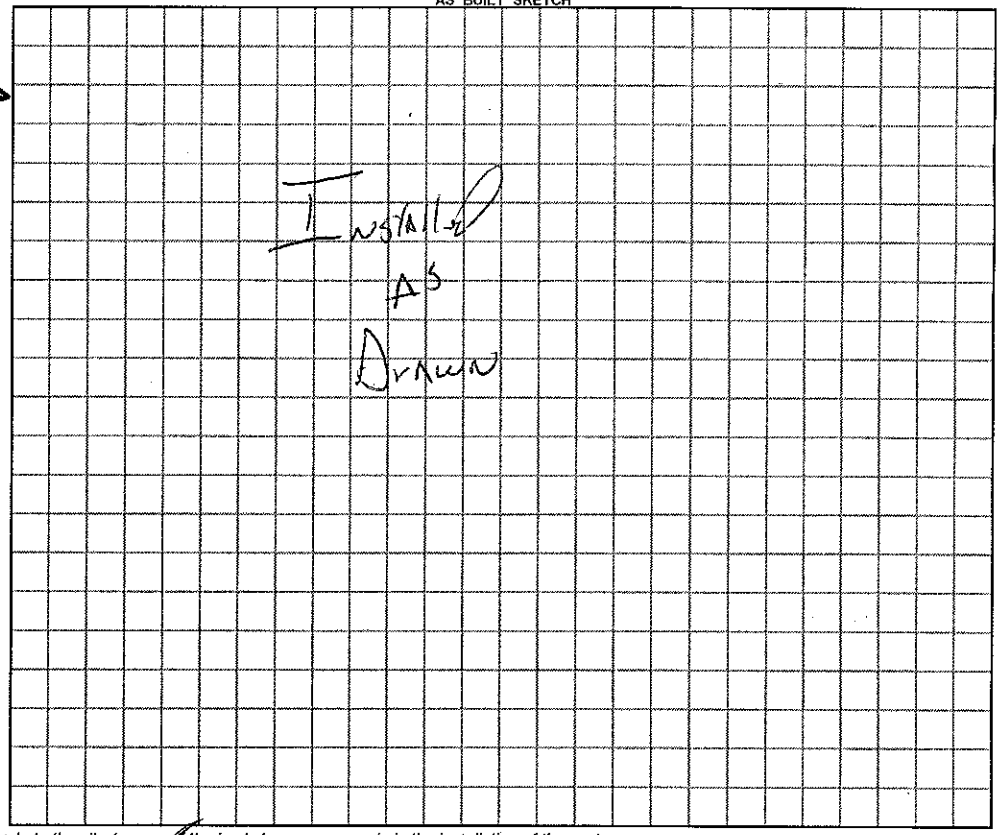

Permit can be suspended or revoked if any false information is supplied toward securing the permit / any unauthorized changes are made to the site / any unauthorized changes are made in the installation of the system.

☐ ***IMPROVEMENT PERMIT*** with plat valid without expiration.
☑ ***IMPROVEMENT PERMIT*** with ~~plat valid without expiration.~~ site plan valid 60 mo.
☑ ***AUTHORIZATION TO CONSTRUCT*** valid for period equal to IMPROVEMENT PERMIT--not to exceed 60 mo.

Owner / Applicant Signature: Date 5-16-11 Installed by: DAVID Yountz

IMPROVEMENT PERMIT by: REHS Date 13 May 11 OPERATION PERMIT by: REHS Date 12/14/2011

AUTHORIZATION TO CONSTRUCT by: REHS Date 13 May 11 Existing System Inspected by: REHS Date

YOU SHOULD CONTACT A LOCATOR SERVICE PRIOR TO ANY EXCAVATION

White Copy – Environmental Health YELLOW COPY (Final) Owner / Applicant PINK COPY (Initial) Owner / Applicant