IREDELL COUNTY HEALTH DEPARTMENT - *ENVIRONMENTAL HEALTH* ☒ STATESVILLE OFFICE 704-878-5305 ☐ MOORESVILLE OFFICE 704-664-5281

IMPROVEMENT PERMIT / AUTHORIZATION TO CONSTRUCT / OPERATION PERMIT / EXISTING SYSTEM INSPECTION

PERMIT # 133995 PIN # 4774-24-1890 DATE 3-6-12

OWNER Michelle & Jason Edwards APPLICANT: Dennis Galliher PHONE: Home/Cell # 704-902-4015 Business #

SITE ADDRESS 536 New Salem Rd OWNER / APPLICANT ADDRESS

SITE DIRECTIONS 64E; (R) New Salem; lot on right, 1½ mi +/-

SUBDIVISION New Salem Estates BLOCK / SECTION LOT # 9 LOT AREA .619 DESIGN FLOW 360 L.T.A.R. .3

Septic Tank 1000 Gallons: STB 1012 Date 7-7-6 ☐ New System ☒ Repair ☐ Expansion System Type I II III IV V VI ☒ Residence No. Bedrooms 3 Water Supply

Pump Tank Gallons: P T Date System Description: 25% Reduction Gravity ☐ Business No. Persons ☐ Private

Pump Make Model Serial # Repair System Description: 50% Reduction Gravity ☐ Other No. Employees ☒ Public


No. Nitrification Fields: 1 No. Lines 5 Linear Feet 300 (ex) Maintenance Agreement Required ☐ YES ☒ NO ☐ Slab ☒ Crawl Space ☐ Community

Trench Width 36" Max. Trench Bottom Depth 36" Gravel Depth n/a ☒ GRAVITY ☐ PRESSURE ☐ Basement w/plumbing ☐ Basement w/o plumbing

Comments / Conditions: Distribution box is under concrete porch

New Salem

INITIAL SITE SKETCH

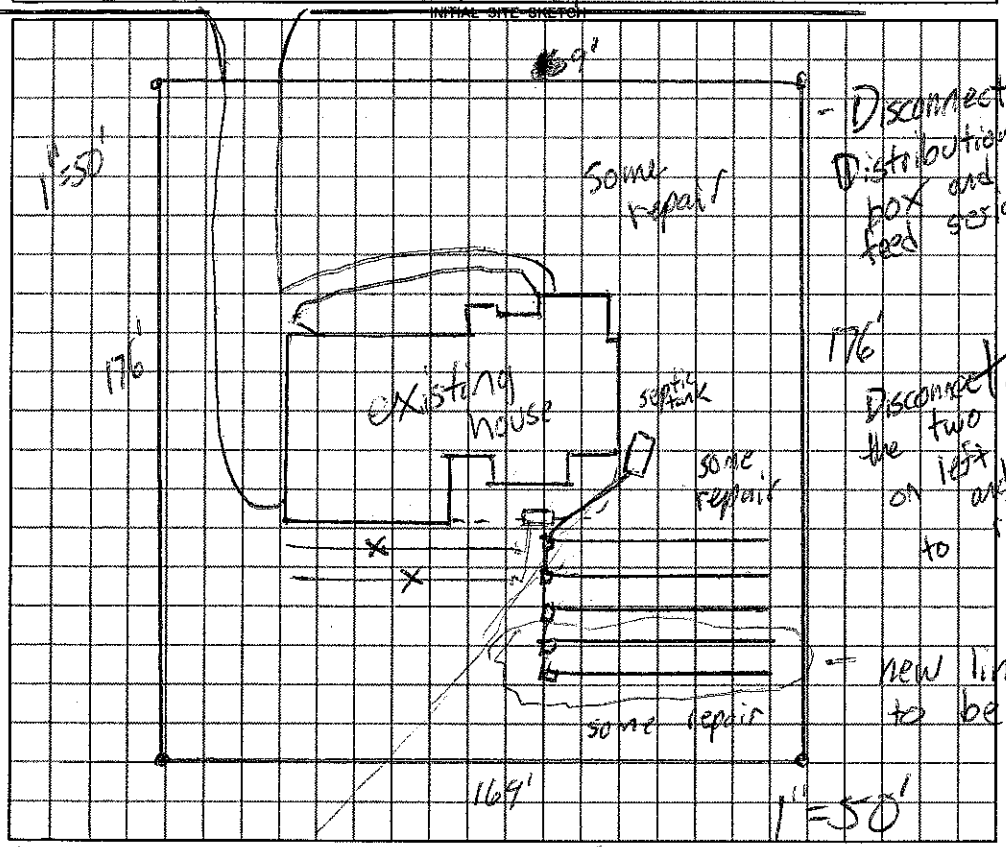

AS BUILT SKETCH

- Disconnect Distribution box and feed serially

Disconnect the two lines on left side and add 120' right side to

- new lines to be added

1"=50'

Permit can be suspended or revoked if any false information is supplied toward securing the permit / any unauthorized changes are made to the site / any unauthorized changes are made in the installation of the system.

☐ ***IMPROVEMENT PERMIT*** with plat valid without expiration. ☒ ***IMPROVEMENT PERMIT*** with ~~plat valid without expiration.~~ site plan valid 60 mo. ☒ ***AUTHORIZATION TO CONSTRUCT*** valid for period equal to IMPROVEMENT PERMIT--not to exceed 60 mo.

Owner / Applicant Signature: Dennis Galliher Date 3-15-12 Installed by: A-1 Backhoe

IMPROVEMENT PERMIT by: James ***REHS*** Date 3-16-12 OPERATION PERMIT by: James ***REHS*** Date 3-8-12

AUTHORIZATION TO CONSTRUCT by: James ***REHS*** Date 3-6-12 Existing System Inspected by: ***REHS*** Date

YOU SHOULD CONTACT A LOCATOR SERVICE PRIOR TO ANY EXCAVATION

White Copy – Environmental Health YELLOW COPY (Final) Owner / Applicant PINK COPY (Initial) Owner / Applicant