Permit #170528 for pool addition 2/1/12 attached.

IREDELL COUNTY HEALTH DEPARTMENT

STATESVILLE 704-878-5305 MOORESVILLE 704-664-5281

IMPROVEMENT PERMIT / AUTHORIZATION TO CONSTRUCT / OPERATION PERMIT / EXISTING SYSTEM INSPECTION

PERMIT# 133495 PIN# 4774241890 DATE 2-1-06

OWNER OR CONTRACTOR Derek Osbare Builders PHONE: Business 704-872-7480 Home

ADDRESS 334 1782 Statesville NC 28687

LOCATION Cliffs Rd New Salem Lot 9 1/2 mile on Right

SUBDIVISION New Salem BLOCK / SECTION 1 LOT 9 LOT AREA 1.19 SITE CLASS P DESIGN FLOW L.T.A.R. 3

Septic Tank: 1000 Gallons; STB 1012 Date 02/09/06

Pump Tank: Gallons; PT Date

Pump Make: Model Serial No.

Nitrification Field: No Fields Square Feet 1200 Linear Feet 300

No Lines 5 Trench Width 36" Max Trench Bottom Depth 36" Gravel Depth NA

☐ New System ☐ Repair System Types: I, II, III, IV, V, VI

System Description: 25% Gravity

Repair System Description: 25% Gravity

Maintenance Agreement Required: ☐ Yes ☐ No

☐ House/Mod. Home No. Bedrooms 3

☐ Mobile Home No. Bathrooms

☐ Business No. Employees

☐ Other

☐ Slab ☐ Crawl Space ☐ Basement w/plumbing ☐ Basement wo/plumbing

Water Supply: ☐ Individual ☐ Public ☐ Community


Comments:/Conditions:

Distribution box 5 speed leveled

Comments:/Conditions:

Maintain all set backs
Installer Certified

INITIAL SITE SKETCH

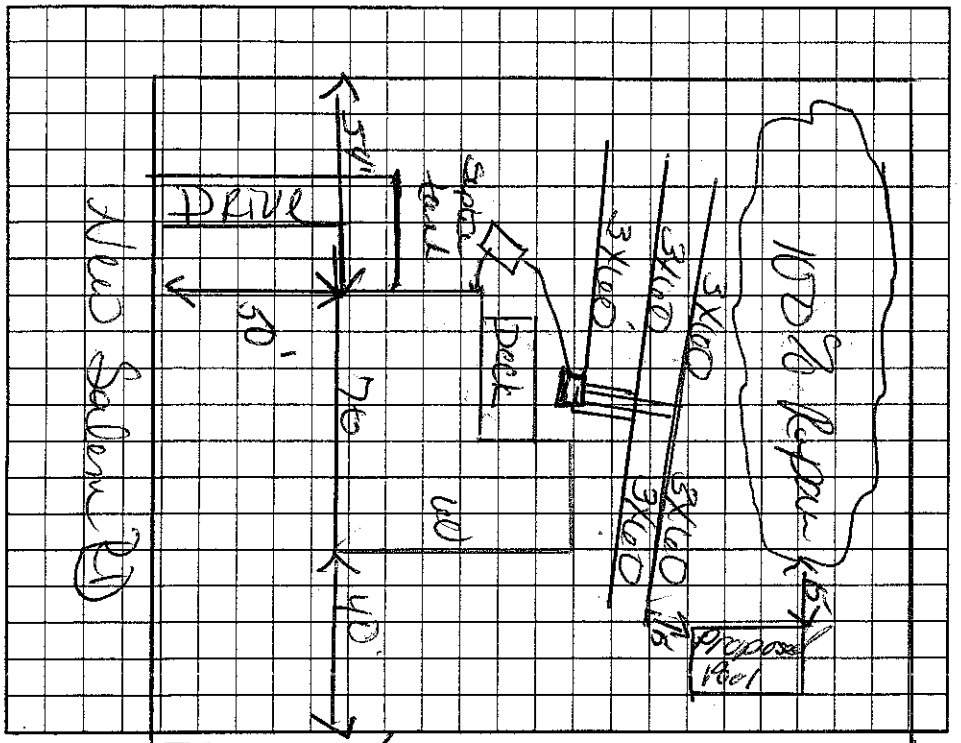

AS BUILT SKETCH

*INSTALLED AS SHOWN

*SYSTEM INSTALLED AFTER RAIN EVENT & BETWEEN RAIN SHOWERS, MOIST TO WET SOIL CONDITIONS.

Permit can be suspended or revoked if any false information is supplied toward securing the permit/any unauthorized changes are made to the site/any unauthorized changes are made in the installation of the system. Improvement Permit with plat valid without expiration. Improvement Permit with site plan valid for sixty months. Authorization to Construct is valid for a period equal to that of Improvement Permit – not to exceed sixty months.

Signed: date 3-20-6 Installed by: KELLY WELBORN GRADING

Improvement Permit by: date 3-1-06 Operation Permit by: date 08/22/06

Authorization to Construct by: date 3-1-06 Existing System Inspection by: date

HEALTH DEPT. COPY: WHITE OWNER COPY (FINAL): YELLOW OWNER COPY (INITIAL): PINK