CI

IREDELL COUNTY HEALTH DEPARTMENT

STATESVILLE 704-878-5305 MOORESVILLE 704-664-5281

IMPROVEMENT PERMIT / AUTHORIZATION TO CONSTRUCT / OPERATION PERMIT / EXISTING SYSTEM INSPECTION

PERMIT# 134861 PIN# 4774251944 DATE 4-27-06

OWNER OR APPLICANT Cool Springs Builders PHONE: Business 704-883-0839 Home

ADDRESS 345 Old Mocksville Road

LOCATION 64E TO New Salem 1 1/2 miles on Right

SUBDIVISION New Salem Estates BLOCK / SECTION I LOT 2 LOT AREA .503 SITE CLASS. PS DESIGN FLOW 360 L.T.A.R. .0125

Septic Tank: 1000 Gallons; STB 1012 Date 2-23-06

Pump Tank: Gallons; PT Date

Pump Make: Model Serial No.

Nitrification Field: No Fields Square Feet 1440 Linear Feet 360

No Lines 3 Trench Width 36" Max Trench Bottom Depth 36"

☐ New System ☐ Repair ☐ Expansion System Type: I II (III) IV V VI

System Description: 25% Grav. LP

Repair System Description: LP Panel

Maintenance Agreement Required: ☐ Yes ☐ No

Gravel Depth ☑ Gravity ☐ Pressure

☑ House/Mod. Home No. Bedrooms 3
☐ Mobile Home No. Persons
☐ Business No. Employees
☐ Other


Water Supply: ☐ Individual ☑ Public ☐ Community

☐ Slab ☑ Crawl Space ☐ Basement w/plumbing ☐ Basement wo/plumbing

Comments:/Conditions:

Comments:/Conditions: 3 - 100' lines 3 speed levels. Install on contour. Maintain all setbacks.

INITIAL SITE SKETCH

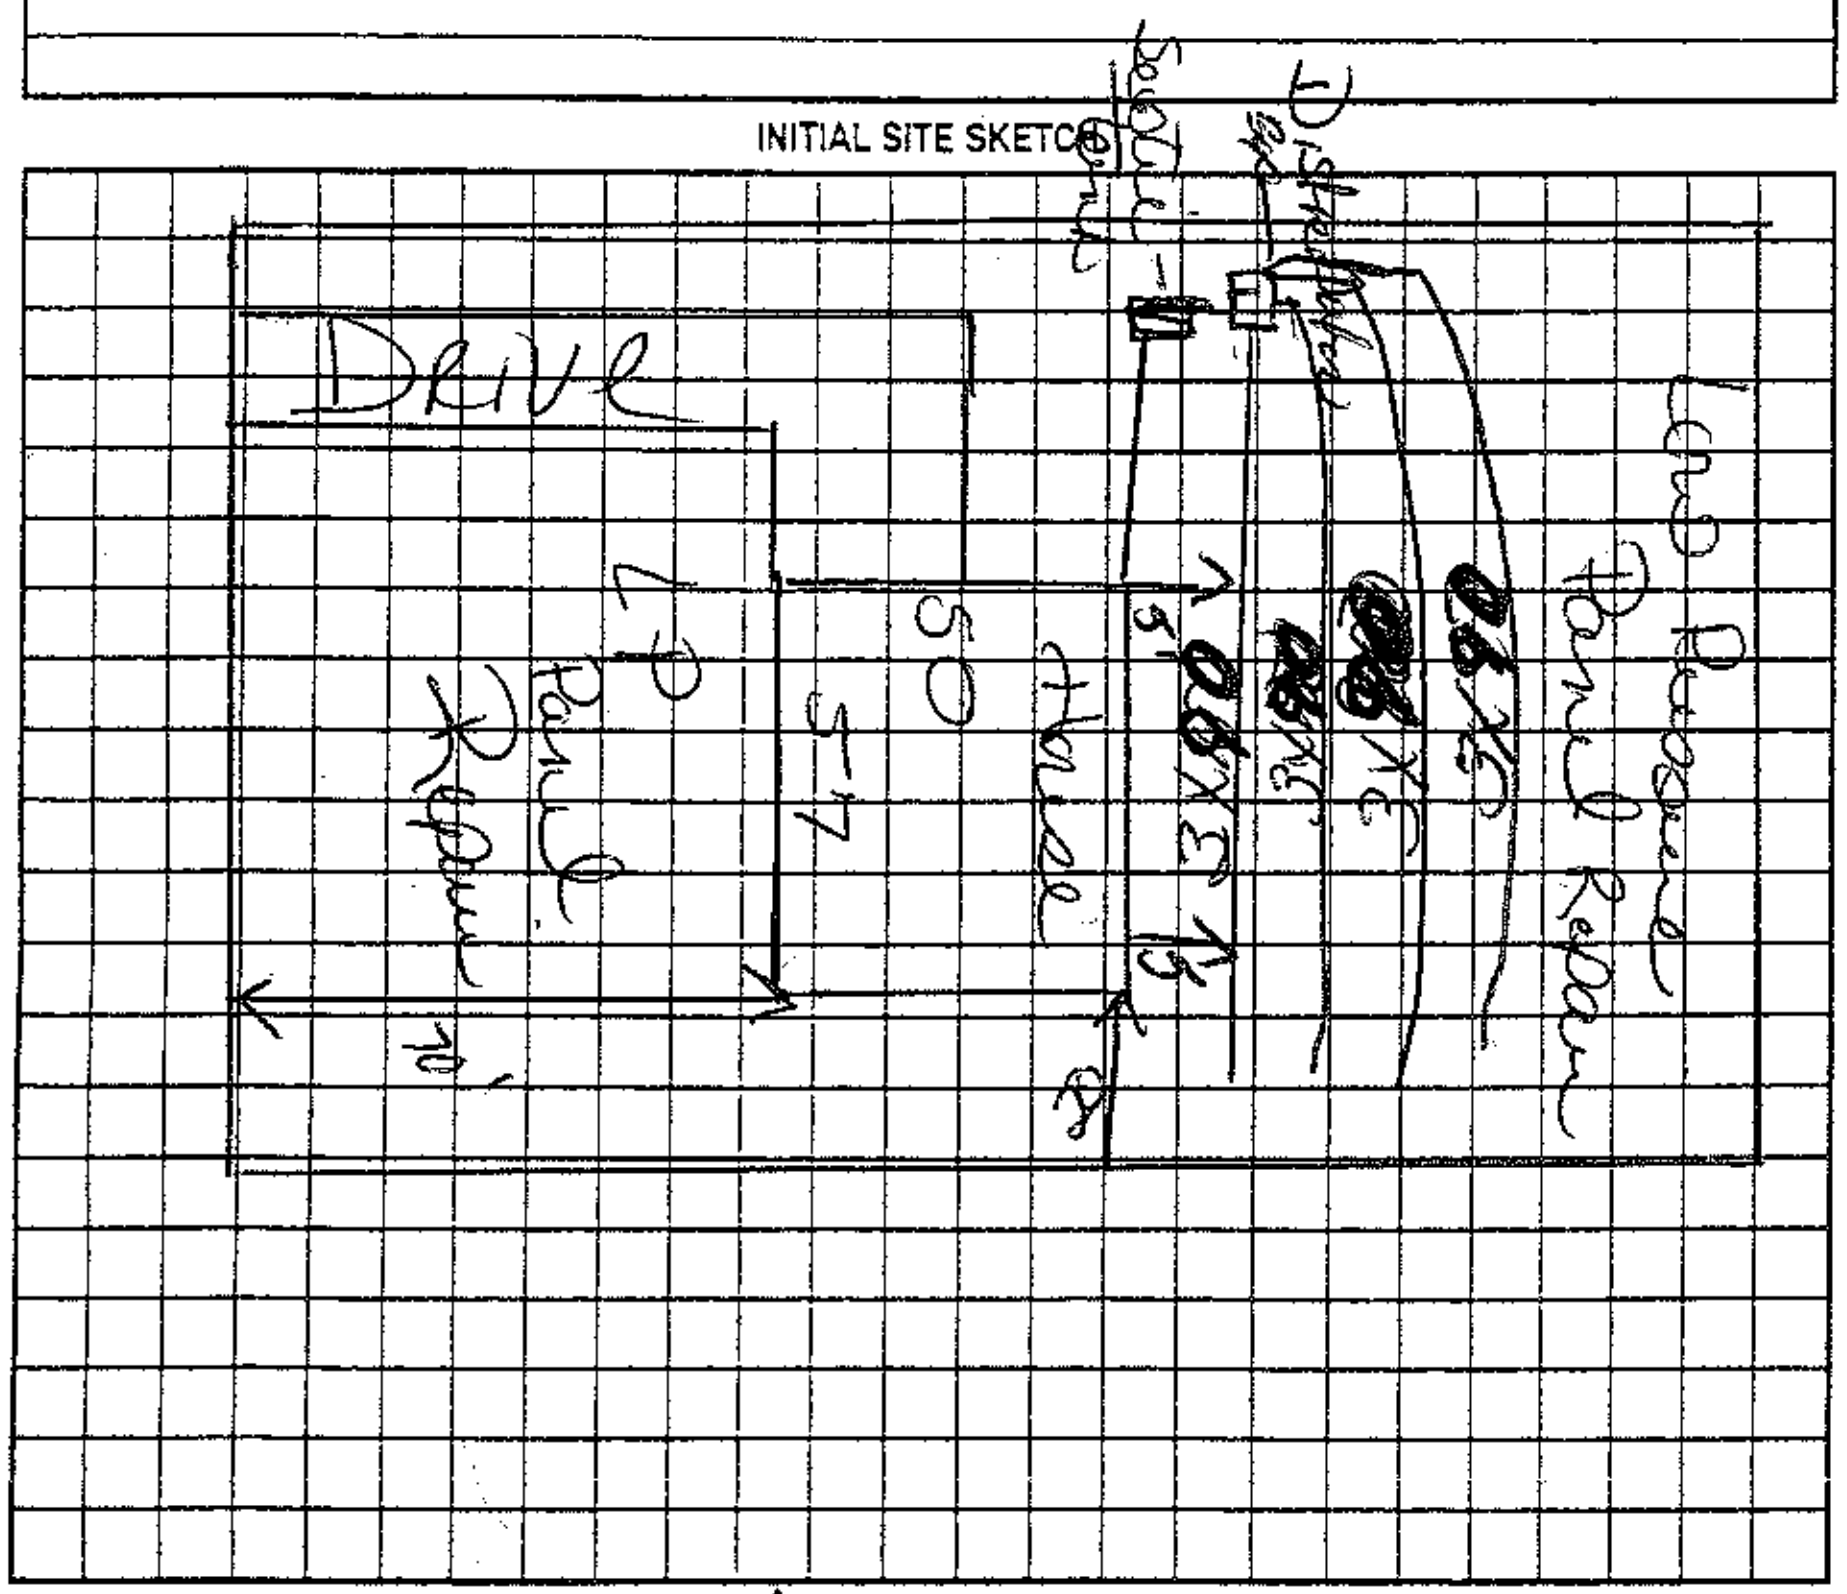

AS BUILT SKETCH

Yellow Sub-Site

Permit can be suspended or revoked if any false information is supplied toward securing the permit/any unauthorized changes are made to the site/any unauthorized changes are made in the installation of the system. Improvement Permit with plat valid without expiration ☐ Improvement Permit with site plan valid for sixty months ☐ Authorization to Construct is valid for a period equal to that of Improvement Permit – not to exceed sixty months.

Signed: [signature] date

Installed by: DAVID YONTZ

Improvement Permit by: Keith Cook date 4-27-06

Operation Permit by: Keith Cook date 8-25-06

Authorization to Construct by: Keith Cook date 4-27-06

Existing System Inspection by: date

HEALTH DEPT. COPY: WHITE OWNER COPY (FINAL): YELLOW OWNER COPY (INITIAL): PINK