5R-2-A-20 50241

IREDELL COUNTY HEALTH DEPARTMENT

STATESVILLE 704-878-5305 MOORESVILLE 704-664-5281

IMPROVEMENT PERMIT / CERTIFICATE OF COMPLETION / OPERATION PERMIT / EXISTING SYSTEM INSPECTION

PROPERTY DESCRIPTION NO. 17723 DATE 1-25-94 TAX MAP NO. ~~5R-2-A-20~~ Watershed: ☐ Yes ☑ No

OWNER OR CONTRACTOR Hayden Hamby Jr. PHONE: Business 5R-2-A-20 Home 872-0825

ADDRESS Rt 5 Box 360-B

LOCATION 642 TR Newsalem Rd TL Salom meadows Dr. 600' on Rt

SUBDIVISION Salom meadows BLOCK / SECTION ____ LOT 20 LOT AREA 1.8022 acres SITE CLASS. PS DESIGN FLOW 360 L.T.A.R. .28

Septic Tank: 1000 Gallons; STB ____ Date ____

Pump Tank: ____ Gallons; PT ____ Date ____

Pump Make: ____ Model ____ Serial No. ____

Nitrification Field: No Fields 1 Square Feet 1350 Linear Feet 450

No Lines 3 Trench Width 3½" Max Trench Bottom Depth 24" Gravel Depth 12"

☑ New System ☐ Repair System Type: I, II, III, IV, V, VI

System Description: Conv. Gravity

Repair System Description: Pump Commercial

Maintenance Agreement Required: ☐ Yes ☑ No

☑ House/Mod. Home No. Bedrooms 3

☐ Mobile Home No. Bathrooms 2

☐ Business No. Employees ____

☐ Other ____


☐ Slab ☑ Crawl Space ☐ Basement w/plumbing ☐ Basement wo/plumbing

Water Supply: ☐ Individual ☐ Community ☑ Public


Comments:

Comments: Landscape so that surface water will not stand over S.T.

INITIAL SITE SKETCH

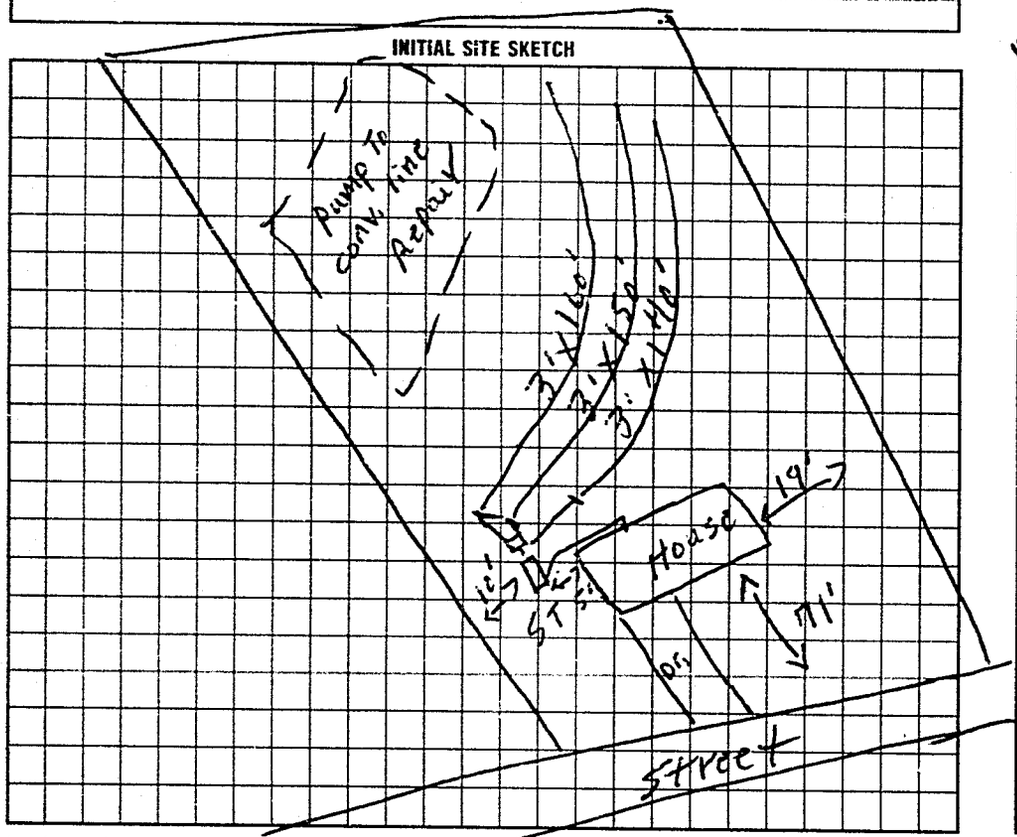

AS BUILT SKETCH

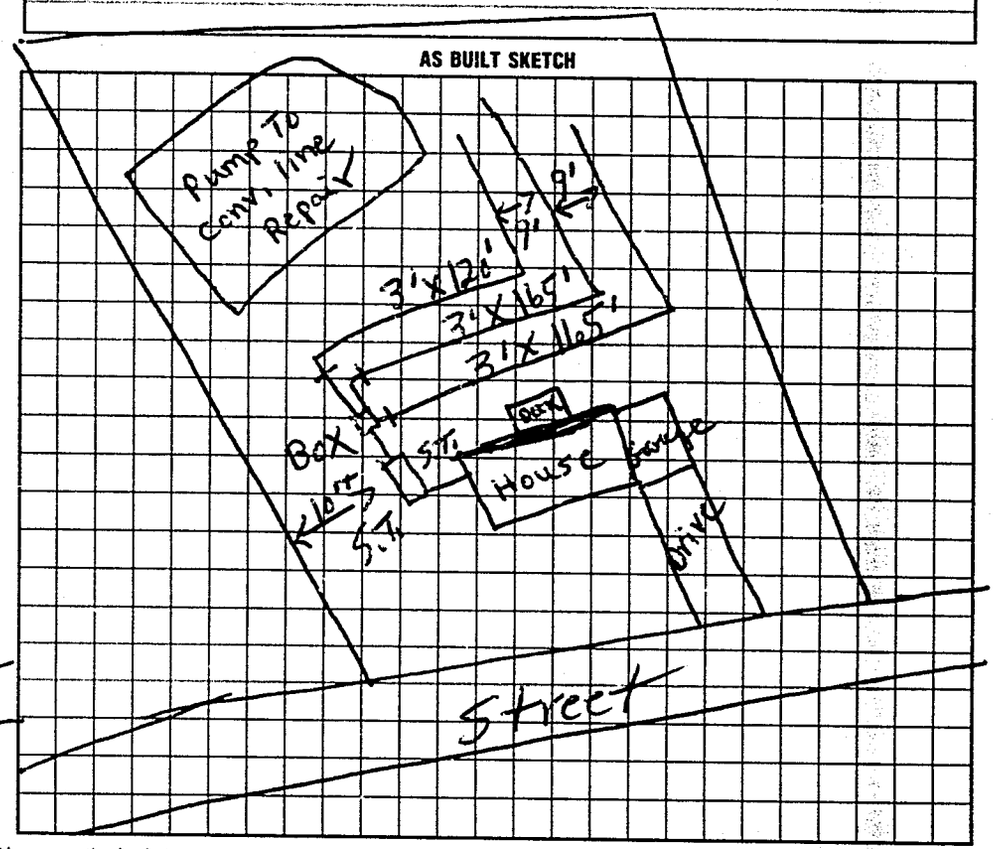

I understand that this permit can be suspended or revoked if any false information is supplied toward securing the permit/any unauthorized changes are made to the site/any unauthorized changes are made in the installation of the system. Improvement Permit is valid for 60 months from date of issuance.

Signed: X Hayden B. Hamby Jr

Improvement Permit by: R.C. Moore date 1-25-94

Existing System Inspection by: ____ date ____

Installed by: A-1 Backhoe

Certificate of Completion by: R.C. Moore date 4-11-94

Operation Permit by: ____ date ____

HEALTH DEPT. COPY: WHITE INSPECTION COPY (FINAL) GREEN OWNER COPY (FINAL): YELLOW INSPECTION COPY (INITIAL): PINK OWNER COPY (INITIAL): GOLD