IREDELL COUNTY HEALTH DEPARTMENT

STATESVILLE 704-878-5305 MOORESVILLE 704-664-5281

IMPROVEMENT PERMIT / AUTHORIZATION TO CONSTRUCT / OPERATION PERMIT / EXISTING SYSTEM INSPECTION

PERMIT# 72981 PIN# ~~3735-55-5599~~ 4774 39 2361 DATE 4-22-98

OWNER OR CONTRACTOR James Blackwelder PHONE: Business Home 336 351 5599

ADDRESS 110 Brinkley Dr. Pilot Mountian, N.C.

LOCATION 64E 1R New Salem Ch Rd TL Salem meadows at end

SUBDIVISION Salem meadows BLOCK / SECTION LOT 13 LOT AREA 5.65 acres SITE CLASS. PS DESIGN FLOW 360 L.T.A.R. .25

Septic Tank: 1000 Gallons; STB 794 Date 8-11-98

Pump Tank: Gallons; PT Date

Pump Make: Model Serial No.

Nitrification Field: No Fields 1 Square Feet 1440 Linear Feet 480

No Lines 2@5 Trench Width 36" Max Trench Bottom Depth 36" Gravel Depth 12"

☐ New System ☐ Repair System Type: I, II, III, IV, V, VI

System Description: Conv. Gravity

Repair System Description:

Maintenance Agreement Required: ☐ Yes ☒ No

☐ House/Mod. Home No. Bedrooms 3

☐ Mobile Home No. Bathrooms 2

☐ Business No. Employees

☐ Other


☐ Slab ☐ Crawl Space ☒ Basement w/plumbing ☐ Basement wo/plumbing

Water Supply: ☐ Individual ☒ Public ☐ Community


Comments:/Conditions:

Comments:/Conditions:

INITIAL SITE SKETCH

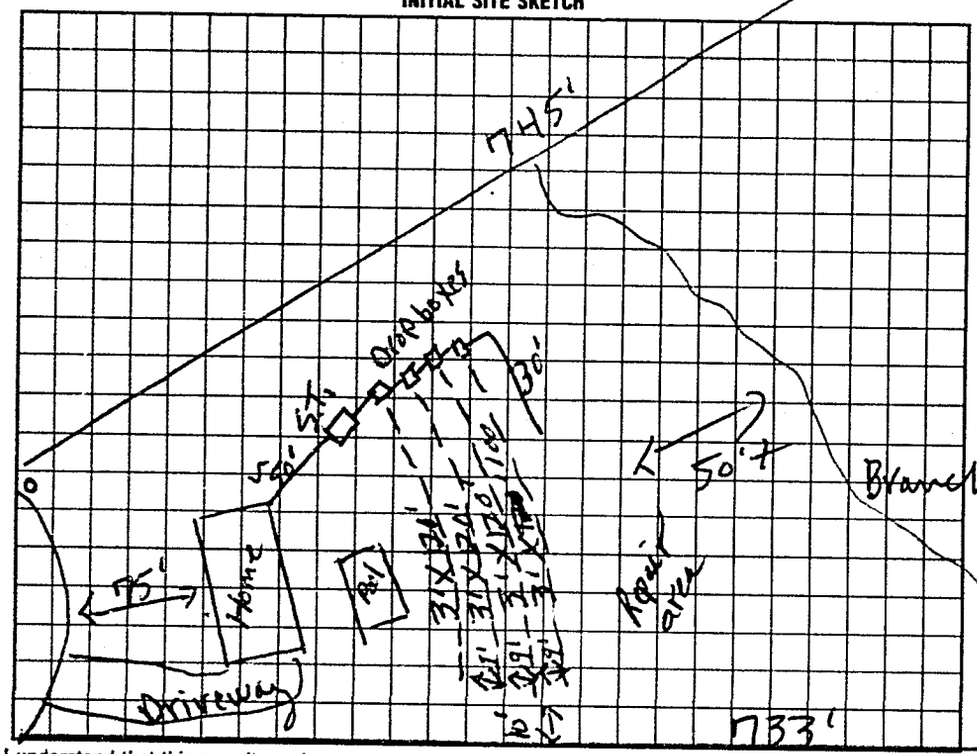

AS BUILT SKETCH

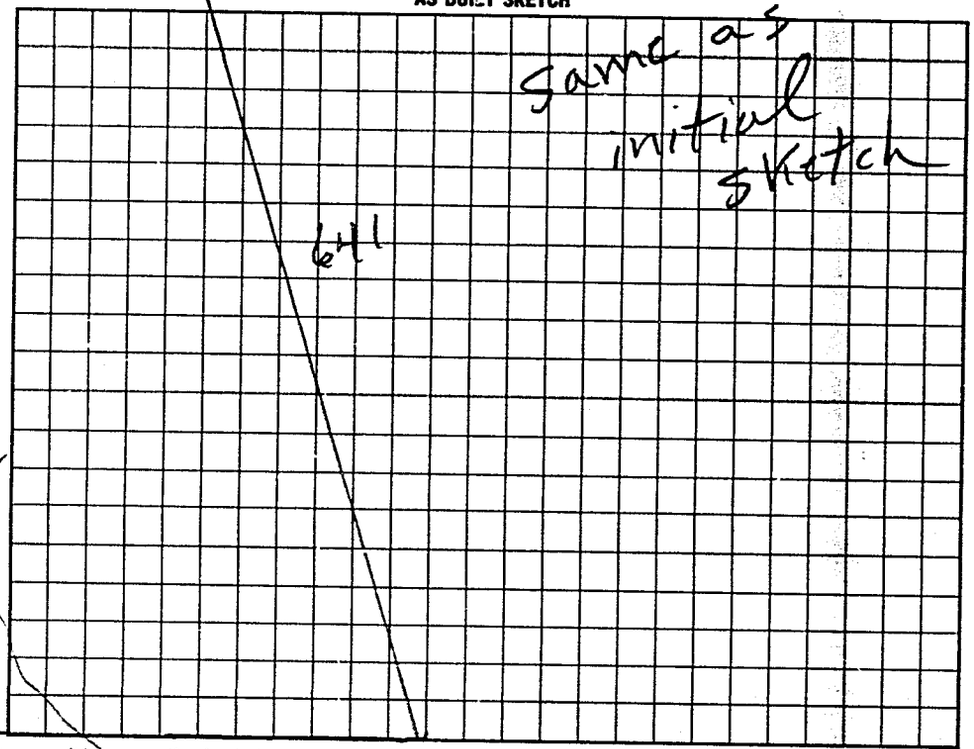

I understand that this permit can be suspended or revoked if any false information is supplied toward securing the permit/any unauthorized changes are made to the site/any unauthorized changes are made in the installation of the system. Improvement Permit with plat valid without expiration. Improvement Permit with site plan valid for sixty months. Authorization to Construct is valid for a period equal to that of Improvement Permit – not to exceed sixty months.

Signed: X James Blackwelder date

Improvement Permit by: L.C. Moore date 4-22-98

Authorization to Construct by: L.C. Moore date 4-22-98

Installed by: Larry Beam

Operation Permit by: L.C. Moore date 12-8-98

Existing System Inspection by: date

HEALTH DEPT. COPY. WHITE INSPECTION COPY (FINAL) GREEN OWNER COPY (FINAL) YELLOW INSPECTION COPY (INITIAL). PINK OWNER COPY (INITIAL). GOLD

12808