IREDELL COUNTY HEALTH DEPARTMENT

STATESVILLE 704-878-5305 MOORESVILLE 704-664-5281

IMPROVEMENT PERMIT / CERTIFICATE OF COMPLETION / OPERATION PERMIT / EXISTING SYSTEM INSPECTION

PROPERTY DESCRIPTION NO. 19962 70221 DATE 7-25-97 TAX MAP NO. 5R-A-43 Watershed: ☐ Yes ☑ No

OWNER OR CONTRACTOR Paul E. Myers PHONE: Business Home 876-4959

ADDRESS ~~P.O. Box~~ 1670 East Broad St. Sta

LOCATION 64E TR New Salem Ch Rd 1mi TL Private Dr. beside Salem Meadows 1/4mi left

SUBDIVISION Piedmont Em BLOCK / SECTION LOT 6 LOT AREA 11.997 acres SITE CLASS. P5 DESIGN FLOW 480 L.T.A. .35 acres

~~Crown Property~~

Septic Tank: 1000 Gallons; STB 1012 Date 9-30-98

Pump Tank: 1000 Gallons; PT 17 Date 8-27-98

Pump Make: Hydromatic Model SHEF 50 A1 Serial No. 5140-0054-17

Nitrification Field: No Fields 1 Square Feet 1380 Linear Feet 460

No Lines 4 Trench Width 36" Max Trench Bottom Depth 24" Gravel Depth 12"

☑ New System ☐ Repair System Type: I, II, III, IV, V, VI

System Description: Pump To conv. lines

Repair System Description: " " "

Maintenance Agreement Required: ☐ Yes ☐ No

☑ House/Mod. Home No. Bedrooms 4

☐ Mobile Home No. Bathrooms 3

☐ Business No. Employees

☐ Other


☐ Slab ☑ Crawl Space ☐ Basement w/plumbing ☐ Basement wo/plumbing

Water Supply: ☑ Individual ☐ Community ☐ Public

Comments:

Comments: Replaces Permit issued 1-3-95 (well location changed)

INITIAL SITE SKETCH

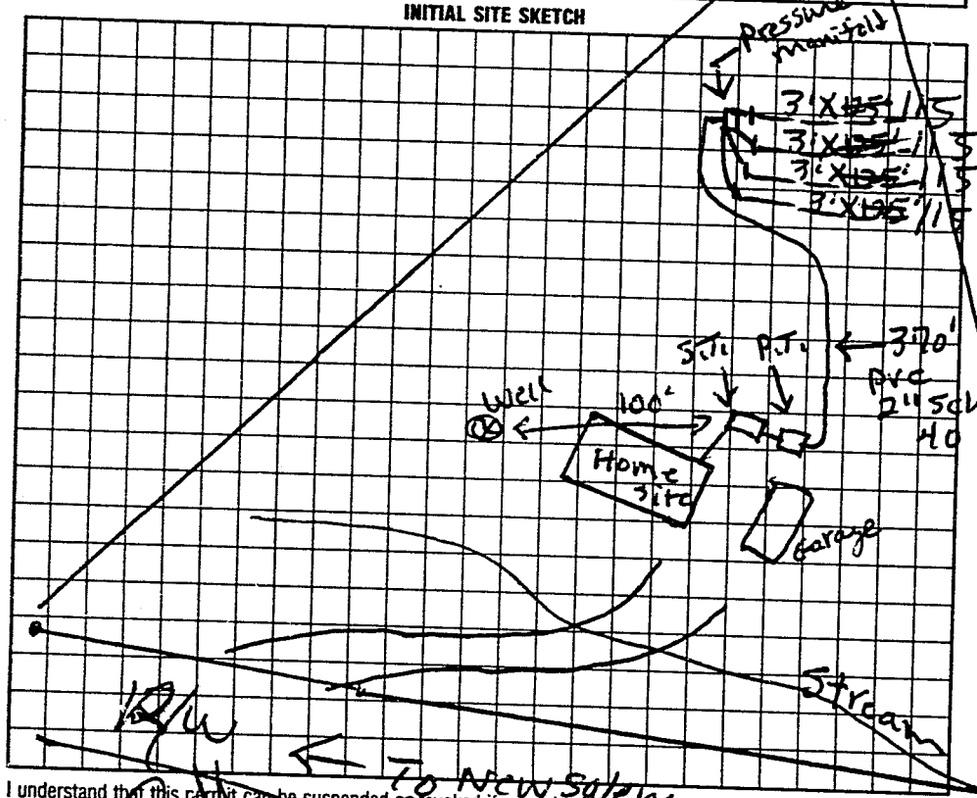

AS BUILT SKETCH

Changed To 3 BR Home 12-9-98 Install 3 115' Drain lines JCM

Checked Drain Lines, manifold, P.T. S.T. Draw down Test JCM 12-10-98 (Pump delivered 40gal/min)

I understand that this permit can be suspended or revoked if any false information is supplied toward securing the permit/any unauthorized changes are made to the site/any unauthorized changes are made in the installation of the system. Improvement Permit is valid for 60 months from date of issuance.

Signed: [signature]

Improvement Permit by: P.C. Moore date 7-25-97 Installed by: Kenny Madison

~~Authorization~~ Existing System Inspection by: P.C. Moore date 7-25-97 Certificate of Completion by: date

to count.

Operation Permit by: P.C. Moore date 12-15-98

HEALTH DEPT. COPY: WHITE INSPECTION COPY (FINAL): GREEN OWNER COPY (FINAL): YELLOW INSPECTION COPY (INITIAL): PINK OWNER COPY (INITIAL): GOLD

Authorization to count Expires 60 mos from issue