4774-48-7347

IREDELL COUNTY HEALTH DEPARTMENT

STATESVILLE 704-878-5305 MOORESVILLE 704-664-5281

IMPROVEMENT PERMIT / CERTIFICATE OF COMPLETION / OPERATION PERMIT / EXISTING SYSTEM INSPECTION

PROPERTY DESCRIPTION NO. 19962 DATE 7-25-97 TAX MAP NO. SR-A-43 Watershed: [ ] Yes [X] No

OWNER OR CONTRACTOR Paul E. Mayers PHONE: Business Home 876-4959

ADDRESS ~~P.O. Box~~ 1170 East Broad St. Statesville

LOCATION 64 E TR New Salem Church 1 mi TL Private Dr. inside Salem Meadows 1/4 mile

SUBDIVISION Pennington Est BLOCK / SECTION LOT 5 LOT AREA 11.997 acres SOIL CLASS PS DESIGN FLOW 480 L.T.A.R. 1.35 acres

Septic Tank 1000 Gallons; STB 1112 Date 9-30-98
Pump Tank: 1000 Gallons; PT 17 Date 8-22-98
Pump Make: Hydromatic Model SKEF 50.41 Serial No. 5146-0001-1
Nitrification Field: No Fields 1 Square Feet 1380 Linear Feet 460
No Lines 4 Trench Width 36" Max Trench Bottom Depth 24" Gravel Depth 12"

[X] New System [ ] Repair System Type: I, II, (III) IV, V, VI
System Description: Pump to conv. lines
Repair System Description:
Maintenance Agreement Required: [ ] Yes [ ] No


[X] House/Mod. Home No. Bedrooms 4
[ ] Mobile Home No. Bathrooms 3
[ ] Business No. Employees
[ ] Other
[ ] Slab [X] Crawl Space [ ] Basement w/plumbing [ ] Basement w/o/plumbing

Water Supply:
[X] Individual
[ ] Community
[ ] Public

Comments:

Comments:
Replace- Permit issued 1-3-95
(well location changed)

INITIAL SITE SKETCH

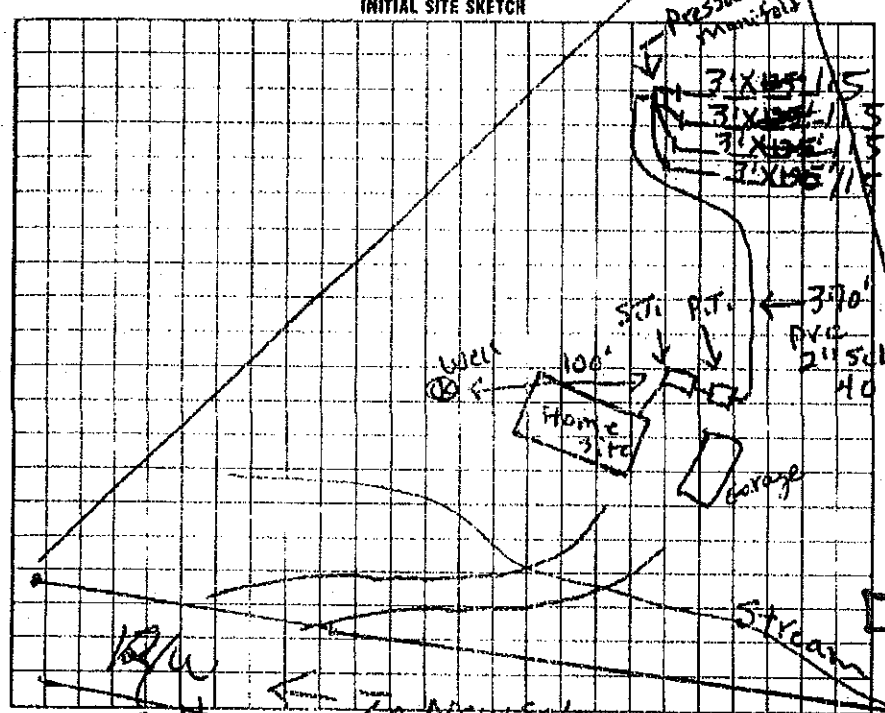

AS BUILT SKETCH

Changed To 3 BR Home
12-9-98 Install 3
115' Drain lines (Conv.)

Checked Drain Lines
Manifold, P.T. Sit.
Draw down test Jan 12-10-99
(Pump delivered 40gal/min)

I understand that this permit can be suspended or revoked if any false information is supplied toward securing the permit/any unauthorized changes are made to the site/any unauthorized changes are made in the installation of the system. Improvement Permit is valid for 60 months from date of issuance.

Signed:

Improvement Permit by: P.C. Moore date 7-25-97
Existing System Inspection by: P.C. Moore date 7-25-97
to cont.

Installed by: Kenny Madison
Certificate of Completion by: date
Operation Permit by: P.C. Moore date 12-15-98

HEALTH DEPT. COPY: WHITE INSPECTION COPY (FINAL): GREEN OWNER COPY (FINAL): YELLOW INSPECTION COPY (INITIAL): PINK OWNER COPY (INITIAL): GOLD

Authorization to cont Expires 60 mos from issue

The location of the proposed Backup addition does not appear to impact the existing septic system. 4
**NOTE:

Date: 2-22-2011 REHS
ICHD-Environmental Health Division