# IREDELL COUNTY HEALTH DEPARTMENT

STATESVILLE 704-878-5305 MOORESVILLE 704-664-5281

## IMPROVEMENT PERMIT / CERTIFICATE OF COMPLETION / OPERATION PERMIT / EXISTING SYSTEM INSPECTION

PROPERTY DESCRIPTION NO. 19962 70221 DATE 7-25-97 TAX MAP NO. 5R-A-43 Watershed: ☐ Yes ☑ No

OWNER OR CONTRACTOR Paul E. Myers PHONE: Business Home 876-4959

ADDRESS [redacted] 1670 East Broad St. Sta

LOCATION 64E TR New Salem Ch Rd 1mi TL Private Dr. beside Salem Meadows 1/4mi left

SUBDIVISION Fairmont Em BLOCK / SECTION LOT 6 LOT AREA 11.990 acres SITE CLASS. PS DESIGN FLOW 480 L.T.A.R. .35 acres

Grevit Property

Septic Tank: 1000 Gallons; STB 1012 Date 9-30-98 ☑ New System ☐ Repair System Type: I, II, III, IV, V, VI ☑ House/Mod. Home No. Bedrooms 4/3 ☑ Individual

Pump Tank: 1000 Gallons; PT 17 Date 8-27-98 System Description: Pump To conv. lines ☐ Mobile Home No. Bathrooms 3 ☐ Community

Pump Make: Hydromatic Model SHEF 50 A1 Serial No. 5140-6058-17 Repair System Description: " " " ☐ Business No. Employees ☐ Public


Nitrification Field: No Fields 1 Square Feet 1380 Linear Feet 460 Maintenance Agreement Required: ☐ Yes ☐ No ☐ Other

No Lines 4 Trench Width 36" Max Trench Bottom Depth 24" Gravel Depth 12" ☐ Slab ☑ Crawl Space ☐ Basement w/plumbing ☐ Basement wo/plumbing

Comments:

Comments: Replaces Permit issued 1-3-95 (well location changed)

INITIAL SITE SKETCH

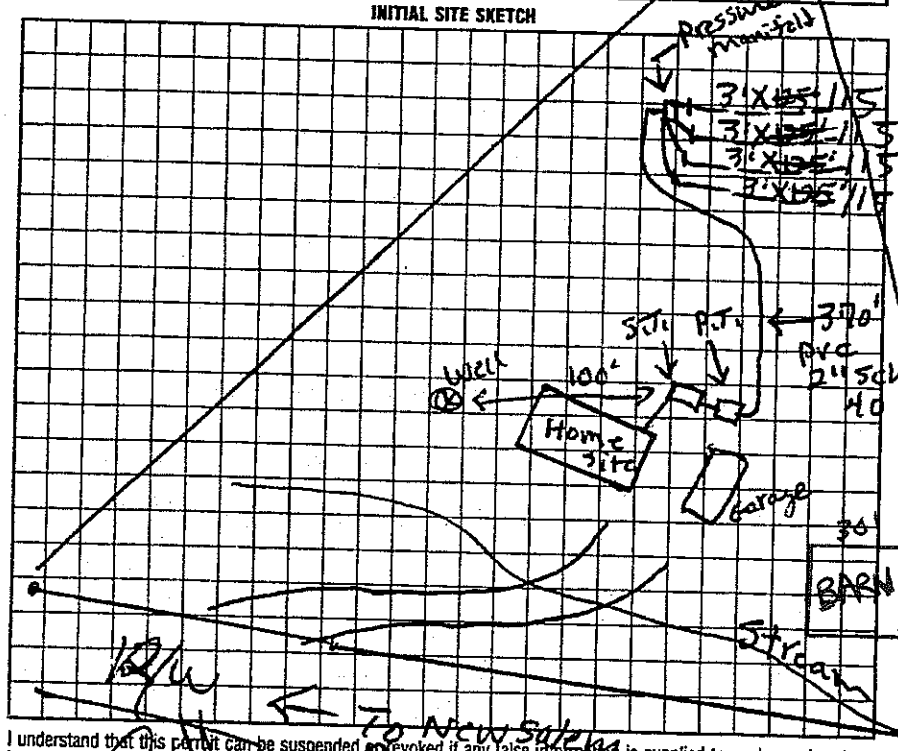


AS BUILT SKETCH

Changed To 3BR Home 12-11-98 Install 3 115' Drain lines (Jam)

Location of the proposed HORSE BARN addition does not appear to impact the existing on-site septic system.**NOTE:

R. STEVE HEDRICK REHS

Date: AUGUST 27, 2012

ICHD-Environmental Health Division

Manifold P.T. S.T.

Draw down Test Jam 12-10-98 (Pump delivered 14gal/min)

I understand that this permit can be suspended or revoked if any false information is supplied toward securing the permit/any unauthorized changes are made to the site/any unauthorized changes are made in the installation of the system. Improvement Permit is valid for 60 months from date of issuance.

Signed: [signature]

Improvement Permit by: P.C. Moore date 7-25-97 Installed by: Kenny Madison

Existing System Inspection by: P.C. Moore date 7-25-97 Certificate of Completion by: date

Authorization to count

HEALTH DEPT. COPY: WHITE INSPECTION COPY (FINAL): GREEN OWNER COPY (FINAL): YELLOW Operation Permit by: P.C. Moore date 12-15-98

INSPECTION COPY (INITIAL): PINK OWNER COPY (INITIAL): GOLD

Authorization to count Expires 60 mos from issue