IREDELL COUNTY HEALTH DEPARTMENT

STATESVILLE 704-878-5305 (1) MOORESVILLE 704-664-5281

IMPROVEMENT PERMIT / AUTHORIZATION TO CONSTRUCT / OPERATION PERMIT / EXISTING SYSTEM INSPECTION

(1)

PERMIT# 125912 PIN# 4774-51-7467 30645 DATE 1-27-05

OWNER OR CONTRACTOR THOMAS McLAUGHLIN PHONE: Business Home 704-902-6068

ADDRESS 721 NEW SALEM ROAD, STATESVILLE, NC 28625

LOCATION US64 EAST, TR NEW SALEM CHURCH ROAD, 2.3 MILES ON LEFT

SUBDIVISION BLOCK / SECTION LOT LOT AREA 241.42 ACRES SITE CLASS. PS DESIGN FLOW 240 L.T.A.R. 0.25 GPD/FT²

Septic Tank: 1000 Gallons; ST8 1007 Date 12-29-04

Pump Tank: Gallons; PT Date

Pump Make: Model Serial No.

Nitrification Field: No Fields 1 Square Feet 960 Linear Feet 320

No Lines THREE Trench Width 36" Max Trench Bottom Depth 36" Gravel Depth 12"

☑ New System ☐ Repair System Type: I, II, III, IV, V, VI

System Description: CONVENTIONAL, GRAVITY

Repair System Description: CONVENTIONAL, GRAVITY

Maintenance Agreement Required: ☐ Yes ☑ No

☑ House/Mod. Home No. Bedrooms 2

☐ Mobile Home No. Bathrooms

☐ Business No. Employees

☐ Other

☐ Slab ☑ Crawl Space ☑ Basement w/plumbing ☐ Basement wo/plumbing


Water Supply: ☑ Individual ☐ Public ☐ Community

WELL


Comments:/Conditions: KEEP SYSTEM MINIMUM 100 FEET FROM WELL.

Comments:/Conditions: SEPTIC TANK WITH MARKER INSTALLED USING "ZABEL" FILTER

INITIAL SITE SKETCH

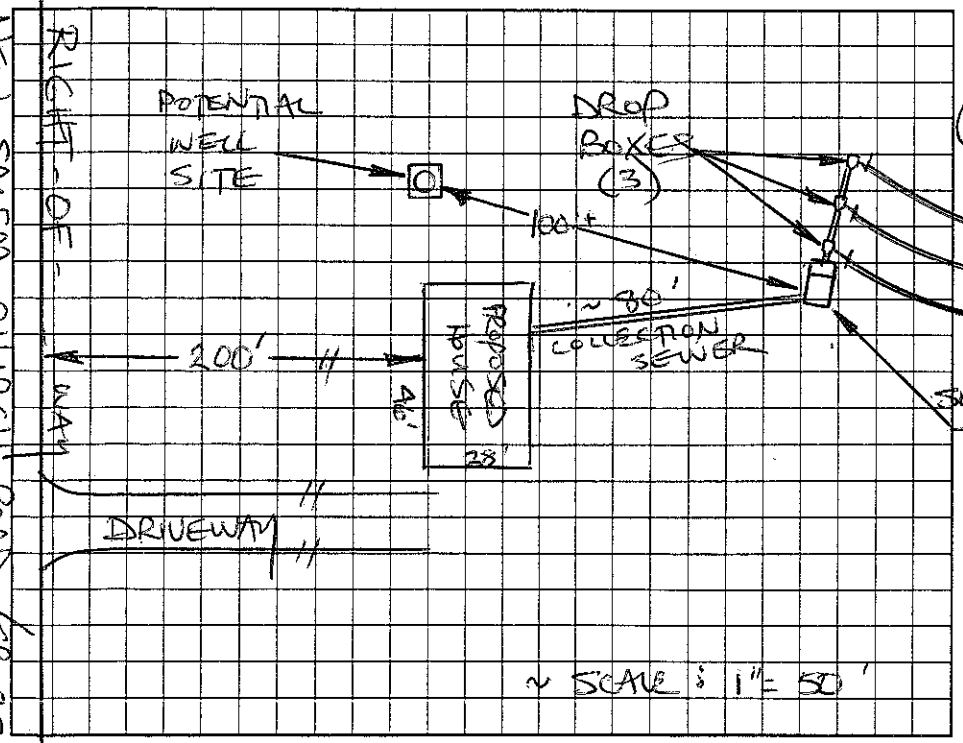

AS BUILT SKETCH

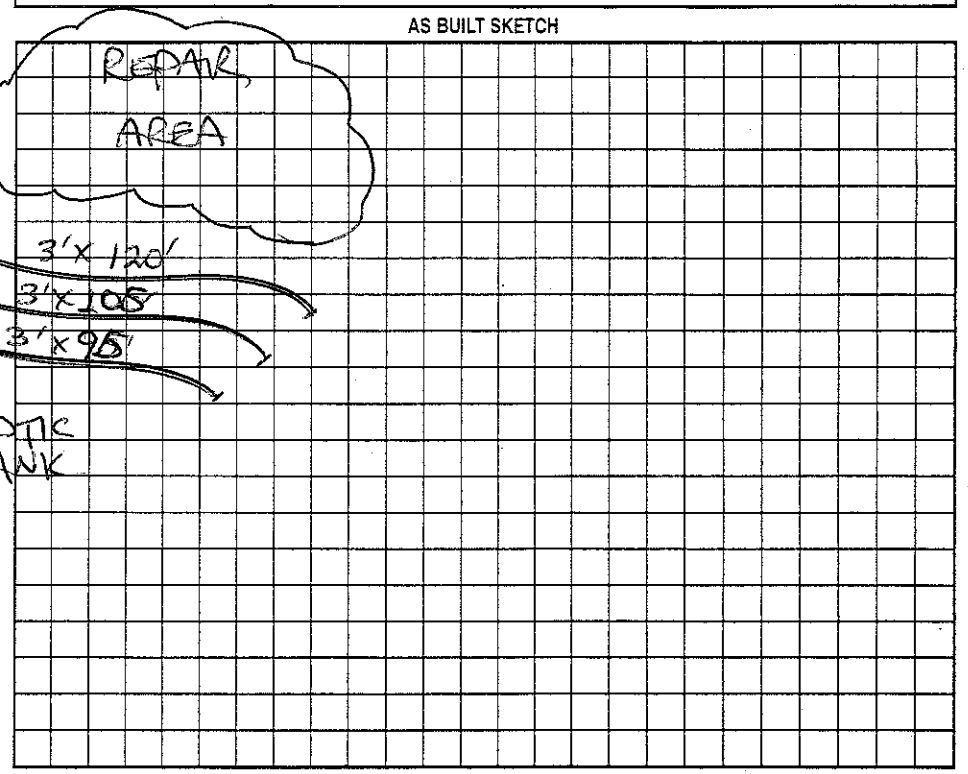

Permit can be suspended or revoked if any false information is supplied toward securing the permit/any unauthorized changes are made to the site/any unauthorized changes are made in the installation of the system. Improvement Permit with plat valid without expiration. Improvement Permit with site plan valid for sixty months. Authorization to Construct is valid for a period equal to that of Improvement Permit – not to exceed sixty months.

Signed: [signature] date 1-27-05 Installed by: Tommy Cothren

Improvement Permit by: Steve Hedrick date 1-27-05 Operation Permit by: Steve Hedrick date 3-24-05

Authorization to Construct by: Steve Hedrick date 1-27-05 Existing System Inspection by: date

HEALTH DEPT. COPY: WHITE OWNER COPY (FINAL): YELLOW OWNER COPY (INITIAL): PINK