# IREDELL COUNTY HEALTH DEPARTMENT

Statesville Office (704) 878-5305 Mooresville Office (704) 660-3625 PERMIT # 208147

## IMPROVEMENT PERMIT / AUTHORIZATION TO CONSTRUCT / OPERATION PERMIT / EXISTING SYSTEM

PIN # 4774564732

APPLICANT: Charles Carter APPLICANT ADDRESS: 378 Mills Garden Rd

SITE ADDRESS: 378 Mills Garden Rd PHONE: 704-873-6020 ALT. PHONE: N/A

SITE DIRECTIONS: 64E T/R Barry Oak Rd T/R Mills Garden Rd lot on right


SUBDIVISION: N/A SECTION: N/A LOT # N/A LOT AREA: 1.33ac DESIGN FLOW: 360g Tank L.T.A.R.: Ex

| | | | | | | | | | |
|---|---|---|---|---|---|---|---|---|---|
| Septic Tank | 1000 (gal) | STB | 620 | Date | 11-21-11 | ☐ New System | ☒ Repair | ☐ Expansion | System Type: I / II / III IV V VI |
| Pump Tank | N/A (gal) | PT | N/A | Date | N/A | System Description: | Tank | | |
| Pump Make | N/A | Model | Taft-Tite | Serial # | EE-4 | Repair System Description: | | | |
| # Nitrification Fields | Ex | # Lines | Ex | Linear Ft: | Ex | Maintenance Agreement Required: | ☐ YES | ☒ NO | |
| Trench Width | Ex | Max. Trench Bottom Depth | Ex | Gravel Depth | Ex | | ☒ GRAVITY | ☐ PRESSURE | |


☒ Residence No. Bedrooms 3 Tank Water Supply
☐ Business No. Persons 6 Tank ☒ Private
☐ Other No. Employees ☐ Public
☐ Slab ☒ Crawl Space ☐ Community
☐ Basement w/plumbing ☐ Basement w/o plumbing

Comments / Conditions: Maintain 5' off any building foundation. Pump, crush, and fill existing tank

INITIAL SITE SKETCH

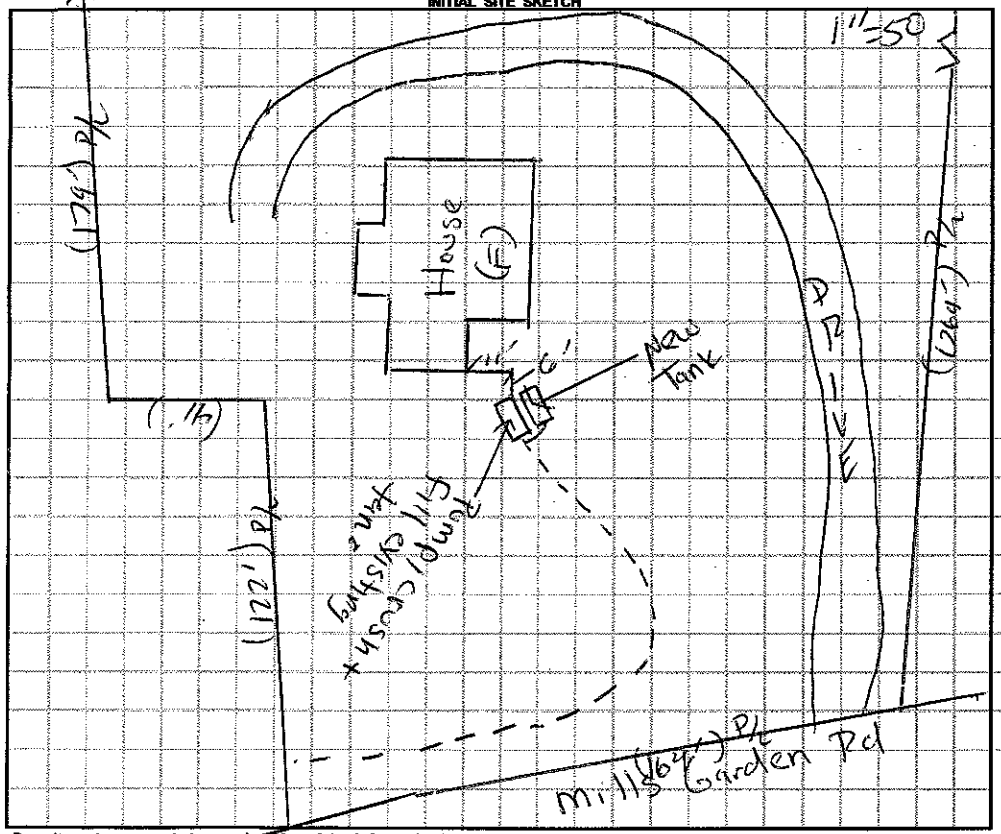


AS BUILT SKETCH

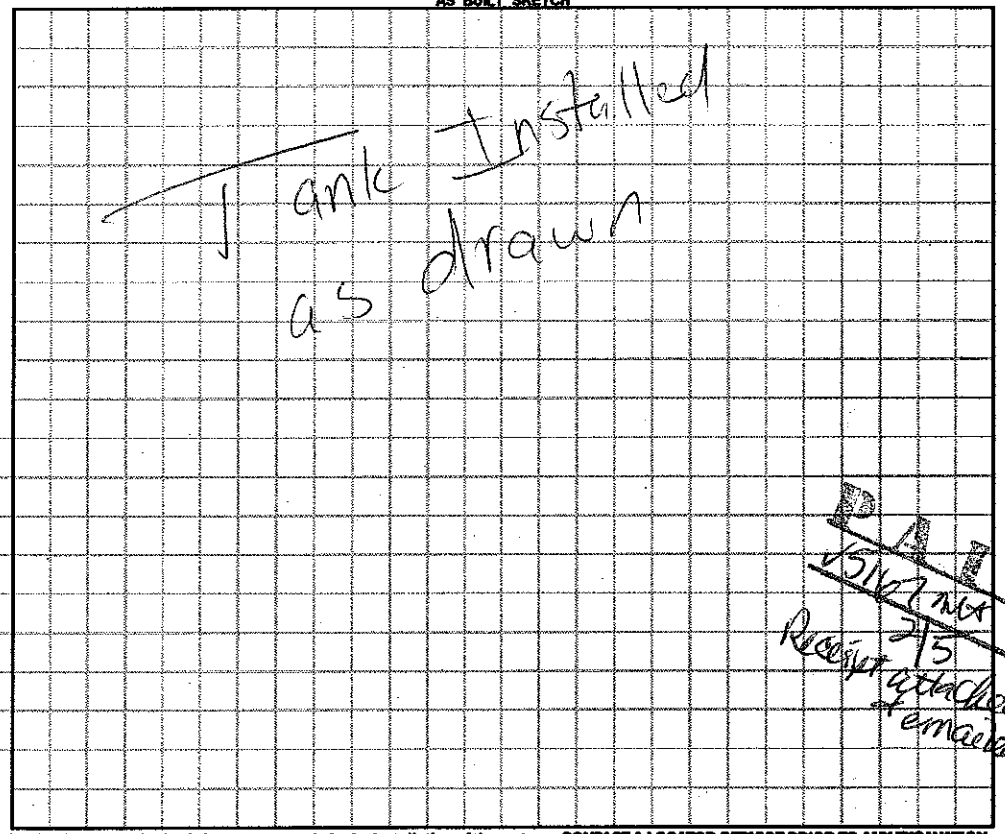


*Permit can be suspended or revoked if any false information is supplied toward securing the permit / any unauthorized changes are made to the site / any unauthorized changes are made in the installation of the system.* **CONTACT A LOCATOR SERVICE PRIOR TO ANY EXCAVATION**

☐ **IMPROVEMENT PERMIT** *with plat valid without expiration.* ☒ **IMPROVEMENT PERMIT** *with site plan valid for 60 mos.* ☒ **AUTHORIZATION TO CONSTRUCT** *valid for period equal to IMPROVEMENT PERMIT--not to exceed 60 mo.*

Owner / Applicant Signature: Charles Carter Date: 2-5-15 Installed by: Sammy Regnis

IMPROVEMENT PERMIT by: Date: 02/05/15 OPERATION PERMIT by: Date: 02/12/15

AUTHORIZATION TO CONSTRUCT by: Date: 02/05/15 Existing System Inspected by: Date:

Health Dept. Copy - WHITE Applicant (Final Approval) - YELLOW Applicant (Conditional Approval) - PINK