IREDELL COUNTY HEALTH DEPARTMENT

STATESVILLE 704-878-5305 MOORESVILLE 704-664-5281

IMPROVEMENT PERMIT / AUTHORIZATION TO CONSTRUCT / OPERATION PERMIT / EXISTING SYSTEM INSPECTION

PERMIT# REPAIR PIN# 4774-58-8150 704-791-2307(M) DATE 1-14-04

OWNER OR CONTRACTOR TRAVIS RICHARDSON PHONE: Business 704-987-2001 Home 704-872-1912

ADDRESS 307 MILLS GARDEN RD, STATESVILLE NC 28625

LOCATION US 64 EAST, TR BARRY OAK RD, TR MILLS GARDEN RD 0.7 MILES ON LEFT AT #307

SUBDIVISION ____ BLOCK / SECTION ____ LOT ____ LOT AREA ACREAGE SITE CLASS. PSI DESIGN FLOW 360 L.T.A.R. EXISTING

Septic Tank: EXISTING Gallons; STB ____ Date ____

Pump Tank: ____ Gallons; PT ____ Date ____

Pump Make: ____ Model ____ Serial No. ____

Nitrification Field: No Fields 1 Square Feet 450 Linear Feet 150

No Lines ONE Trench Width 36" Max Trench Bottom Depth 36" Gravel Depth 18"

☐ New System ☑ Repair System Type: I (II) III, IV, V, VI

System Description: CONVENTIONAL GRAVITY

Repair System Description: CONVENTIONAL GRAVITY

Maintenance Agreement Required: ☐ Yes ☑ No

☑ House/Mod. Home No. Bedrooms 3

☐ Mobile Home No. Bathrooms 1

☐ Business No. Employees ____

☐ Other ____

☐ Slab ☑ Crawl Space ☐ Basement w/plumbing ☑ Basement wo/plumbing


Water Supply: ☑ Individual ☐ Public ☐ Community

WELL

Comments:/Conditions: ① INSTALL NEW DRAINLINE AS SHOWN USING 18" STONE. ② KEEP SYSTEM MINIMUM 100' FROM WELL ③ THIS PERMIT SERVES AS "NOTICE OF VIOLATION" SYSTEM TO BE REPAIRED BY 1-15-2004.

Comments:/Conditions:

INITIAL SITE SKETCH

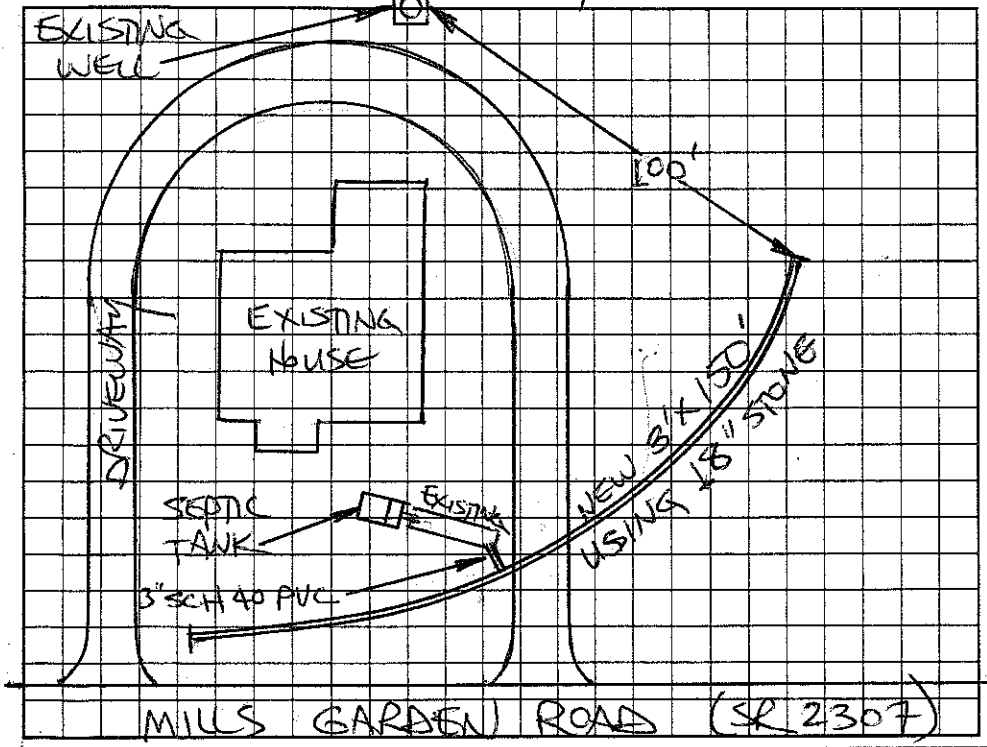

AS BUILT SKETCH

SYSTEM REPAIRED ACCORDING TO INITAL SITE SKETCH

Permit can be suspended or revoked if any false information is supplied toward securing the permit/any unauthorized changes are made to the site/any unauthorized changes are made in the installation of the system. Improvement Permit with plat valid without expiration. Improvement Permit with site plan valid for sixty months. Authorization to Construct is valid for a period equal to that of Improvement Permit – not to exceed sixty months.

Signed: ____ date 1-14-04

Improvement Permit by: STEVE HEDRICK date 1-14-04

Authorization to Construct by: STEVE HEDRICK date 1-14-04

Installed by: TUCKER'S HAULING & GRADING

Operation Permit by: STEVE HEDRICK date 2-24-04

Existing System Inspection by: ____ date ____

HEALTH DEPT. COPY: WHITE OWNER COPY (FINAL): YELLOW OWNER COPY (INITIAL): PINK