IREDELL COUNTY HEALTH DEPARTMENT

Statesville Phone TR 3-7271 Mooresville Phone NO 3-1271

PERMIT TO INSTALL SEPTIC TANK

Permit NO. _____ Permit Date 6-20-1964

Owner ? Martin Address Rt Statesville

Installed By C Hoke Address R7

Location of Property Right on 1st blacktop past Beavers store. 6 + 8. past Salem Met. ch. go until you wonder if lost. then you are


Tank		Capacity		Length of Lines		Fixtures	
Block	( )	1000	( )	225'	(✓)	No. of Baths	( )
Precast	(✓)	1250	( )	250'	( )	Dishwasher	( )
		1500	( )	Other _____		Garbage Grdr.	( )
		Other _____				Other trailer	

end of Rd.

NOTIFY HEALTH DEPARTMENT AT LEAST EIGHT HOURS BEFORE TANK IS TO BE INSPECTED.

Final Inspection 6-20 1964 Approved (✓) Disapproved ( )

Remarks No water this date.

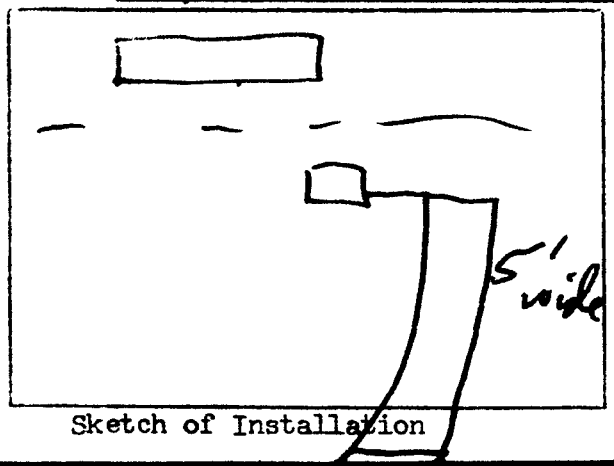

Sketch of Installation

Rt.

Sanitarian