IREDELL COUNTY HEALTH DEPARTMENT

STATESVILLE 704-878-5305 MOORESVILLE 704-664-5281

IMPROVEMENT PERMIT / AUTHORIZATION TO CONSTRUCT / OPERATION PERMIT / EXISTING SYSTEM INSPECTION

PERMIT# 128750 PIN# 4774-64-2386 DATE 4-26-06

OWNER OR APPLICANT KEVIN HORTON PHONE: Business 704-929-8702 Home 704-873-7563

ADDRESS 500 MILLS GARDEN ROAD, STATESVILLE NC 28625

LOCATION US 64 EAST TR BARRY OAK ROAD, TR MILLS GARDEN ROAD, ON RIGHT AT BOX #500, off ROAD 400'

SUBDIVISION MILLS GARDEN FARMS BLOCK / SECTION LOT 24 LOT AREA 3.96 ACRES SITE CLASS. PS DESIGN FLOW 360 L.T.A.R. 0.25 GPD/FT²

Septic Tank: 1000 Gallons; STB 1012 Date 2-4-05

Pump Tank: 1000 Gallons; PT 17 Date 4-13-05

Pump Make: GOULDS Model WE05111HA Serial No.

Nitrification Field: No Fields 1 Square Feet 1440 Linear Feet 360

No Lines 5 ONE (NEW) Trench Width 36" Max Trench Bottom Depth 36" Gravel Depth N/A ☐ Gravity ☑ Pressure

☑ New System ☐ Repair ☐ Expansion System Type: I II (III) IV V VI

System Description: 25% REDUCTION, PUMP

Repair System Description: 50% REDUCTION, LOW-PRESS

Maintenance Agreement Required: ☐ Yes ☑ No

☑ House/Mod. Home ☐ Mobile Home ☐ Business ☐ Other

No. Bedrooms 3 No. Persons ___ No. Employees ___


Water Supply: ☐ Individual ☑ Public ☐ Community

☐ Slab ☐ Crawl Space ☑ Basement w/plumbing ☐ Basement wo/plumbing


Comments/Conditions: ① REMOVE LAST TWELVE FEET of DRAINLINE INSTALLED BENEATH DRIVEWAY ON EXISTING FIVE LINES. ② INSTALL NEW 3'x60' LINE AT LOCATION SHOWN ON CONTOUR NO. DEEPER THAN 36"

Comments/Conditions:

INITIAL SITE SKETCH

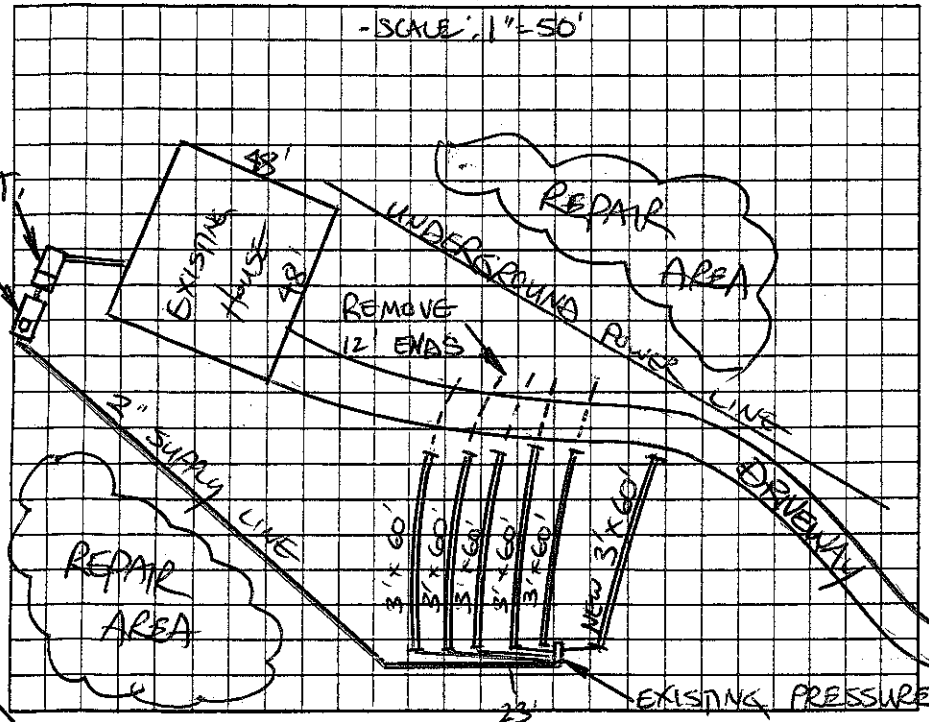

AS BUILT SKETCH

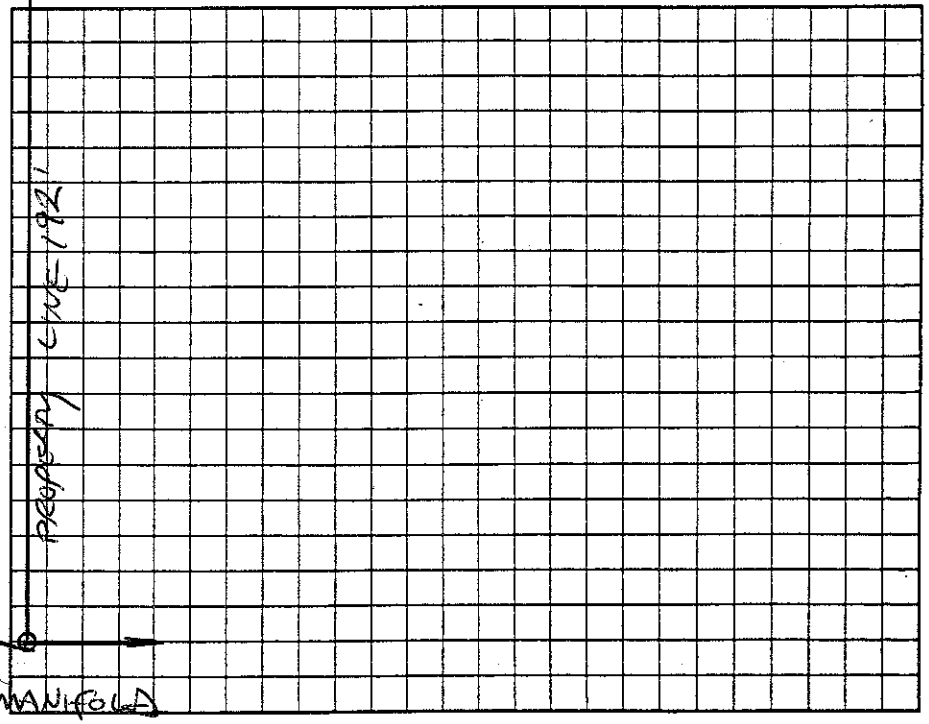

Permit can be suspended or revoked if any false information is supplied toward securing the permit/any unauthorized changes are made to the site/any unauthorized changes are made in the installation of the system. Improvement Permit with plat valid without expiration ☐ Improvement Permit with site plan valid for sixty months ☑ Authorization to Construct is valid for a period equal to that of Improvement Permit – not to exceed sixty months.

Signed: Kevin Horton date 4-26-06 Installed by: A-1 Backhoe

Improvement Permit by: STEVE HEDRICK date 4-26-06 Operation Permit by: Kelly Cook date 5-2-06

Authorization to Construct by: STEVE HEDRICK date 4-26-06 Existing System Inspection by: ___ date ___

HEALTH DEPT. COPY: WHITE OWNER COPY (FINAL): YELLOW OWNER COPY (INITIAL): PINK