IREDELL COUNTY HEALTH DEPARTMENT

STATESVILLE 704-878-5305 (C) MOORESVILLE 704-664-5281

IMPROVEMENT PERMIT / AUTHORIZATION TO CONSTRUCT / OPERATION PERMIT / EXISTING SYSTEM INSPECTION

PERMIT# 115 437 PIN# 4774-64-6545 DATE 9-12-03

OWNER OR CONTRACTOR WAYNE HOMES MID ATLANTIC, LLC PHONE: Business 704-872-8989 ~~Home~~ 704-872-0271

ADDRESS 130 VICTORY LANE STATESVILLE, NC 28625

LOCATION US 64 EAST TR BARRY OAK RD, TR MILLS GARDEN ROAD, 1.6 MILES ON RIGHT

SUBDIVISION MILLS GARDEN PARK BLOCK / SECTION 1 LOT 3 LOT AREA 0.84 ACRE SITE CLASS. PS DESIGN FLOW 360 L.T.A.R. 0.25 GPD/FT²

Septic Tank: 1000 Gallons; STB 794 Date 10-4-03
Pump Tank: ____ Gallons; PT ____ Date ____
Pump Make: ____ Model ____ Serial No. ____
Nitrification Field: No Fields 1 Square Feet 1440 Linear Feet 480
No Lines FOUR Trench Width 36" Max Trench Bottom Depth 36" Gravel Depth 12"

☒ New System ☐ Repair System Type: I, II, III, IV, V, VI
System Description: CONVENTIONAL, GRAVITY
Repair System Description: CONVENTIONAL, PUMP
Maintenance Agreement Required: ☐ Yes ☒ No

~~☒~~ House/Mod. Home No. Bedrooms 3
☐ Mobile Home No. Bathrooms 2
☐ Business No. Employees ____
☐ Other ____
☐ Slab ☒ Crawl Space ☐ Basement w/plumbing ☐ Basement wo/plumbing


Water Supply:
☐ Individual
☒ Public
☐ Community

Comments:/Conditions: KEEP SYSTEM MINIMUM 15' FROM POOL

Comments:/Conditions: SEPTIC TANK WITH MARKER INSTALLED USING "ZABEL" FILTER

SCALE: 1" = 50'

INITIAL SITE SKETCH

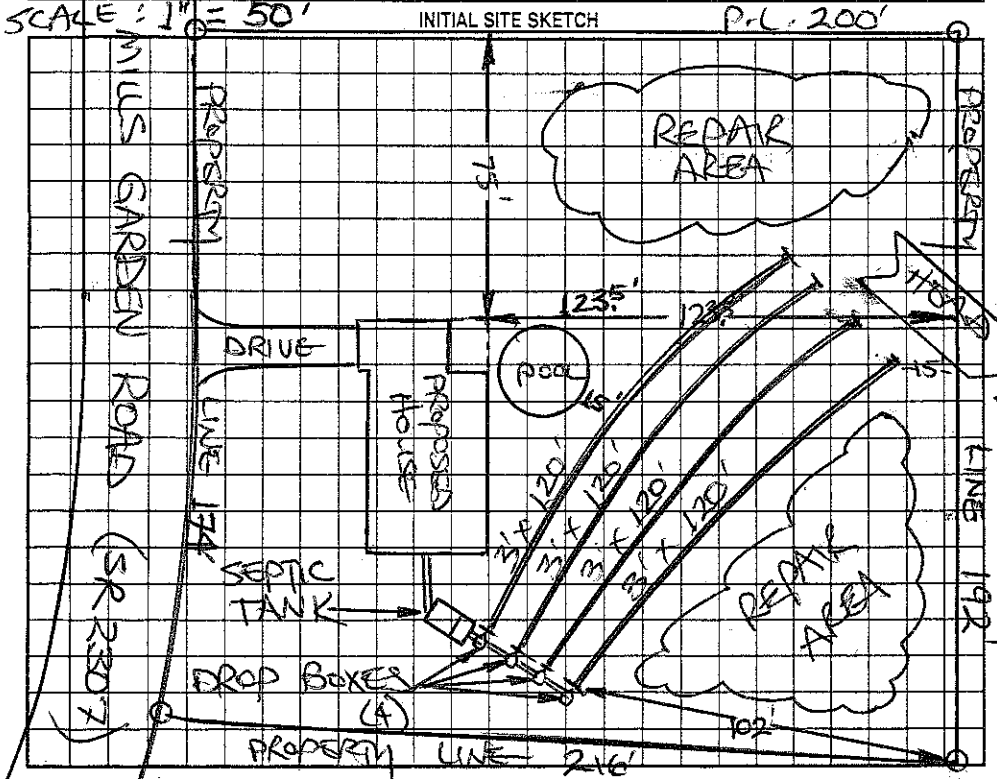

AS BUILT SKETCH

SYSTEM INSTALLED ACCORDING TO INITAL SITE SKETCH

Permit can be suspended or revoked if any false information is supplied toward securing the permit/any unauthorized changes are made to the site/any unauthorized changes are made in the installation of the system. Improvement Permit with plat valid without expiration. Improvement Permit with site plan valid for sixty months. Authorization to Construct is valid for a period equal to that of Improvement Permit – not to exceed sixty months.

Signed: + Sean Dahlgren date 9-12-03

Improvement Permit by: STEVE HEDRICK date 9-12-03

Authorization to Construct by: STEVE HEDRICK date 9-12-03

Installed by: TUCKER'S HAULING & GRADING

Operation Permit by: STEVE HEDRICK date 12-9-03

Existing System Inspection by: ____ date ____

HEALTH DEPT. COPY: WHITE OWNER COPY (FINAL): YELLOW OWNER COPY (INITIAL): PINK