IREDELL COUNTY HEALTH DEPARTMENT

Statesville Office (704) 878-5305 Mooresville Office (704) 660-3625 PERMIT # 214473

IMPROVEMENT PERMIT / AUTHORIZATION TO CONSTRUCT / OPERATION PERMIT / EXISTING SYSTEM

PIN # 4774647398

APPLICANT: Anthony + Sylvan Pools APPLICANT ADDRESS: 8334-A Arrowridge Blvd.

SITE ADDRESS: 506 Mills Garden Rd. PHONE: 704-773-4426 ALT. PHONE: 704-759-7630

SITE DIRECTIONS: Hwy 64 TR Barry Oak Rd TR Mills Garden Rd. Property on Right

SUBDIVISION: Mills Garden Farms SECTION: N/A LOT # 4 LOT AREA: 0.84 acres DESIGN FLOW: 360gpd L.T.A.R.: 0.25

Septic Tank	Existing	(gal)	STB		Date				
Pump Tank		(gal)	PT		Date				
Pump Make			Model		Serial #				
# Nitrification Fields	1		# Lines	2	Linear Ft:	120			
Trench Width	36"		Max. Trench Bottom Depth	36"	Gravel Depth	N/A			

☐ New System ☐ Repair ☐ Expansion System Type: I II (III) IV V VI

System Description: 25% Reduction

Repair System Description: 50% Reduction

Maintenance Agreement Required: ☐ YES ☑ NO

☑ GRAVITY ☐ PRESSURE

☑ Residence No. Bedrooms 3

☐ Business No. Persons 6

☐ Other No. Employees

☐ Slab ☑ Crawl Space


☐ Basement w/plumbing ☐ Basement w/o plumbing

Water Supply: ☐ Private ☑ Public ☐ Community


Comments / Conditions: ★ Disconnect upper existing drainline ★ Install 120' of 25% Reduction on contour with serial distribution as shown below & connect to 2 remaining existing Drainlines.

May need to relocate collection sewer to attain 15' setback to pool area.

INITIAL SITE SKETCH

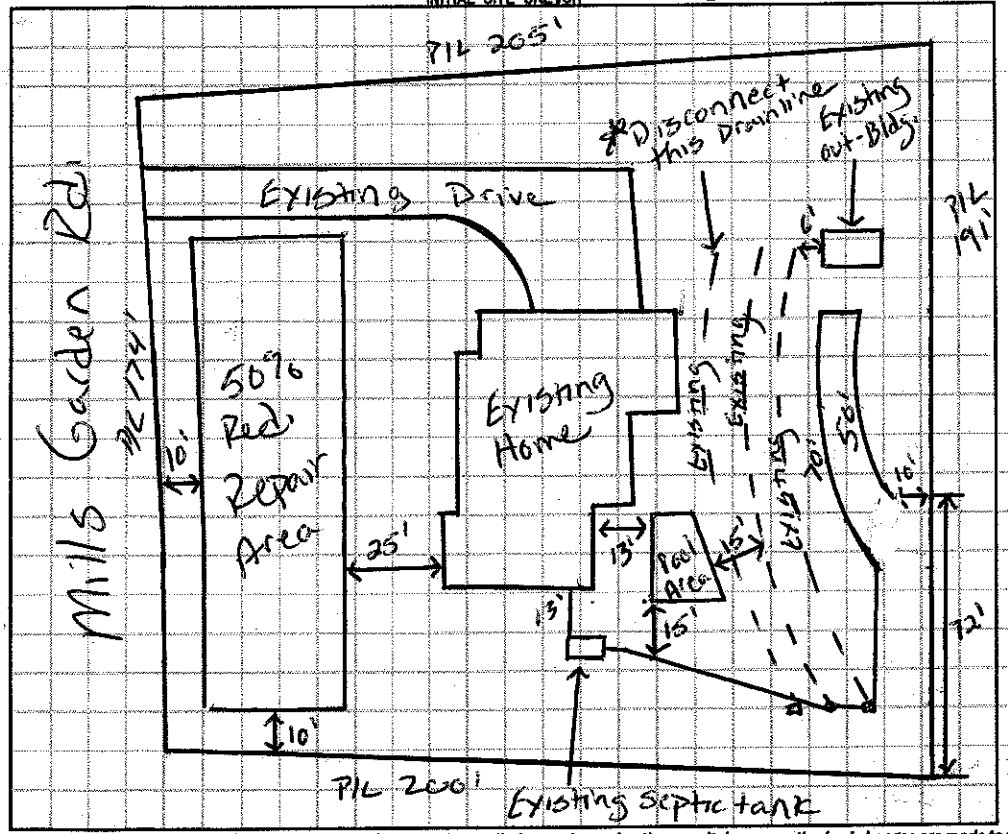

AS BUILT SKETCH

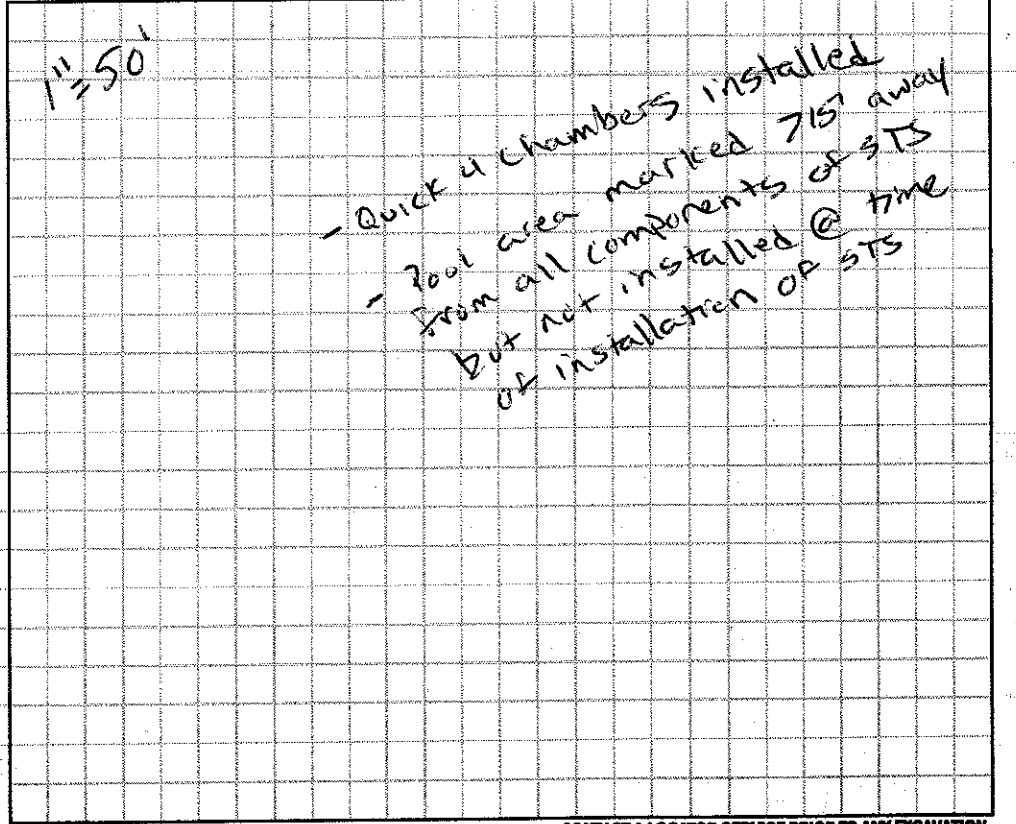

Permit can be suspended or revoked if any false information is supplied toward securing the permit / any unauthorized changes are made to the site / any unauthorized changes are made in the installation of the system. **CONTACT A LOCATOR SERVICE PRIOR TO ANY EXCAVATION**

☐ **IMPROVEMENT PERMIT** *with plat valid without expiration.* ☑ **IMPROVEMENT PERMIT** *with site plan valid for 60 mos.* ☐ **AUTHORIZATION TO CONSTRUCT** *valid for period equal to IMPROVEMENT PERMIT--not to exceed 60 mo.*

Owner / Applicant Signature: [signature] Date: 1-29-16 Installed by: Specialty Septic

IMPROVEMENT PERMIT by: Justin Henderson Date: 1-29-16 OPERATION PERMIT by: Justin Henderson Date: 2-26-16

AUTHORIZATION TO CONSTRUCT by: Justin Henderson Date: 1-29-16 Existing System Inspected by: Date:

Health Dept. Copy - WHITE Applicant (Final Approval) - YELLOW Applicant (Conditional Approval) - PINK