IREDELL COUNTY HEALTH DEPARTMENT

STATESVILLE 704-878-5305 MOORESVILLE 704-664-5281

IMPROVEMENT PERMIT / AUTHORIZATION TO CONSTRUCT / OPERATION PERMIT / EXISTING SYSTEM INSPECTION

PERMIT# EXISTING PIN# 4774-64-9696 DATE 08-05-02

OWNER OR CONTRACTOR PERRY YODER PHONE: Business 962-2437 Home 704-872-3537

ADDRESS 503 MILLS GARDEN ROAD STATESVILLE NC 28625

LOCATION 64E, ⓡ GARY OAK, ⓡ MILLS GARDEN, ⓛ AT BOX # 503 / RED METAL ROOF

SUBDIVISION MILLS GDN FARMS BLOCK / SECTION ____ LOT 12 LOT AREA 1.96 AC SITE CLASS. PS DESIGN FLOW ____ L.T.A.R. ____

Septic Tank: ~~1000~~ EXISTING Gallons: STB 760 Date 11/8/94

Pump Tank: ____ Gallons: PT ____ Date ____

Pump Make: ____ Model ____ Serial No ____

Nitrification Field: No Fields 1 Square Feet ____ Linear Feet 225'

No Lines 3x75' Trench Width 36" Max Trench Bottom Depth 36" Gravel Depth 12"

☐ New System ☐ Repair System Type: I ⓘ II III IV V VI

System Description: CONV GRAV

Repair System Description: GRAV 25% RED/ CONV

Maintenance Agreement Required: ☐ Yes ☒ No

☐ House/Mod Home ☒ Mobile Home D/W ☐ Business ☐ Other

No. Bedrooms 3 No. Bathrooms 2 No. Employees ____


☐ Slab ☒ Crawl Space ☐ Basement w/plumbing ☐ Basement w/o plumbing

Water Supply: ☒ Individual ☐ Public ☐ Community WELL


Comments/Conditions: ⓘ SEE BELOW

Comments/Conditions: DID NOT HAVE DROP BOX ON LAST LINE. HAD TO ADD 2 NEW DROP BOXES INSTEAD OF ONE. LOPUE COOK, RS 10-23-02

INITIAL SITE SKETCH NOT TO SCALE

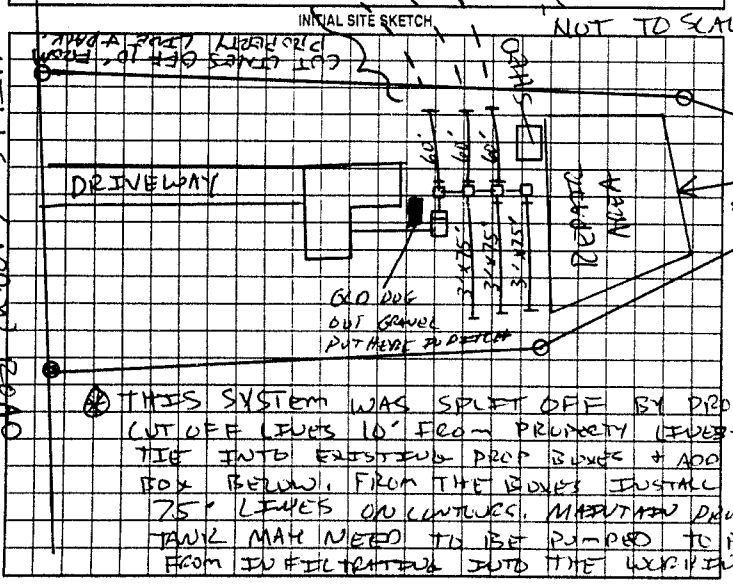

AS BUILT SKETCH

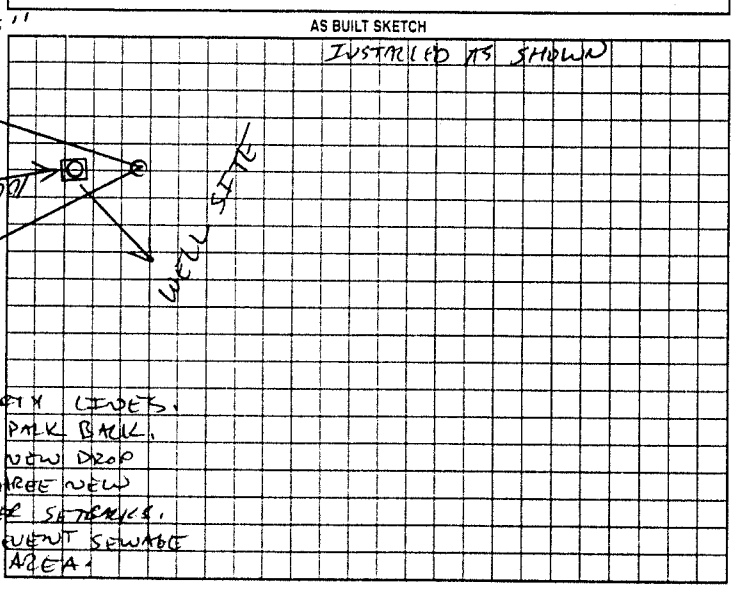

ⓡ THIS SYSTEM WAS SPLIT OFF BY PROPERTY LINES. CUT OFF LINES 10' FROM PROPERTY LINES + PACK BACK. TIE INTO EXISTING DROP BOXES + ADD 1 NEW DROP BOX BELOW. FROM THE BOXES INSTALL THREE NEW 75' LINES ON CONTOURS. MAINTAIN DROPPER SERVICES. TANK MAY NEED TO BE PUMPED TO PREVENT SEWAGE FROM INFILTRATING INTO THE EXISTING AREA.

Permit can be suspended or revoked if any false information is supplied toward securing the permit; any unauthorized changes are made to the site; any unauthorized changes are made in the installation of the system. Improvement Permit with plat valid without expiration. Improvement Permit with site plan valid for sixty months. Authorization to Construct is valid for a period equal to that of Improvement Permit - not to exceed sixty months

Signed: Perry Yoder date 8/5-02 installed by JUDY TRAVIS

Improvement Permit by: [signature] date 08-05-02 Operation Permit by [signature] date 10-23-02

Authorization to Construct by: [signature] date 08-05-02 Existing System Inspection by: ____ date ____

HEALTH DEPT COPY: WHITE OWNER COPY (FINAL): YELLOW OWNER COPY (INITIAL): PINK