Paid $120.00
9/3/09

CI 75 110

IREDELL COUNTY HEALTH DEPARTMENT

STATESVILLE 704-878-5305 MOORESVILLE 704-664-5281

IMPROVEMENT PERMIT / AUTHORIZATION TO CONSTRUCT / OPERATION PERMIT / EXISTING SYSTEM INSPECTION

PERMIT# 102649 PIN# 4774-65-0047 DATE

OWNER OR CONTRACTOR JENNIFER SHERRILL PHONE Business 704-924-2586 Home 704-873-4562

ADDRESS 440 HILLCREST DR STATESVILLE, NC 28677

LOCATION HWY 64 E @ BARCY OAK, @ MILLS GROOM, 84 TIMBER LN ON RT

SUBDIVISION MILLS GROOM ESTS BLOCK / SECTION LOT 17 LOT AREA 0.944 SITE CLASS PS DESIGN FLOW 360 L.T.A.R. 1.25

Septic Tank: 1000 Gallons, STB 760 Date 8-11-01
Pump Tank: Gallons, PT Date
Pump Make: Model Serial No
Nitrification Field: No Fields 1 Square Feet 60=1440 Linear Feet 360
No Lines 4 Trench Width 36" Max Trench Bottom Depth 36" Gravel Depth 12"

X New System Repair System Type I II III IV V
System Description GRAV 25% RED
Repair System Description LP PANEL
Maintenance Agreement Required: Yes X No

X House/Mod. Home No Bedrooms 3
Mobile Home No. Bathrooms 2
Business No Employees
Other


Water Supply: Individual, X Public, Community

Slab X Crawl Space Basement w/plumbing Basement w/o plumbing

Comments/Conditions: ① STUB OUT 2' HIGHER THAN GROUND LEVEL BRACKFILL TO PREVENT PUMPING ② DO NOT CUT GROUND LEVEL ANY AT STUBOUT; IF CUT THE SYSTEM WILL BECOME A PUMP. ③ STUB OUT


Comments/Conditions: AS SHOWN IN BACK RIGHT CORNER WHICH MEANS THROUGH GARAGE FLOOR ④ MAINTAIN SEPTEMICS ZABC FILTER ⑤ MASTER

INITIAL SITE SKETCH 1"=50'

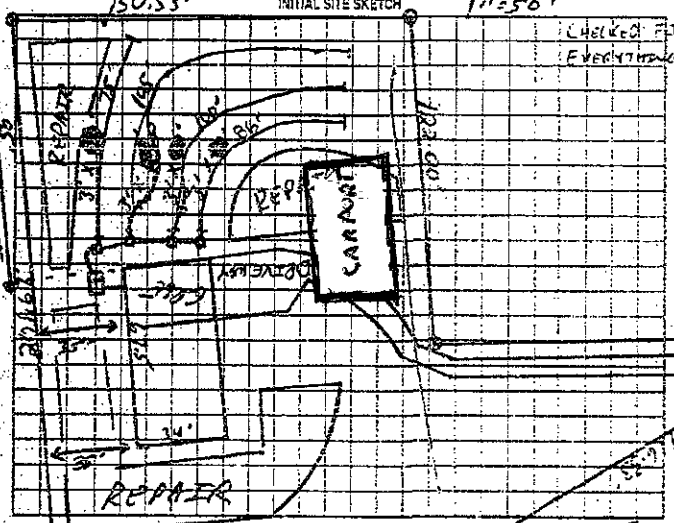

AS BUILT SKETCH

CHECKED FIRST TANK (LINES) + TANK 12-4-01
EVERYTHING OK 12-5-01

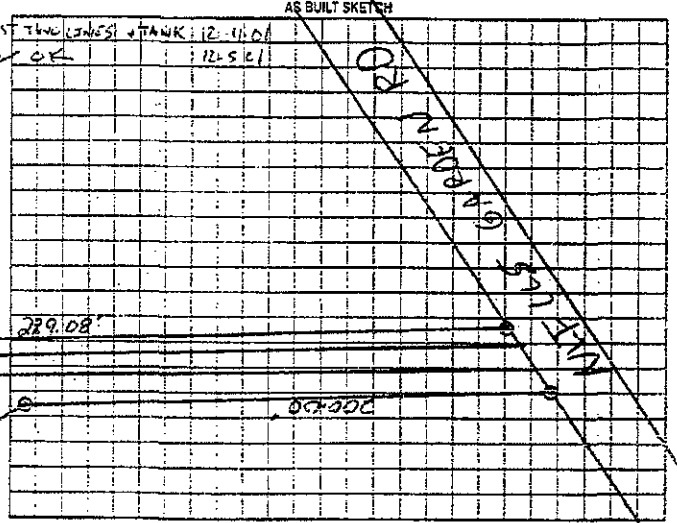

Permit can be suspended or revoked if any false information is supplied to/and sealing the permit, any unauthorized changes are made to the site any unauthorized changes are made in the installation of the system. Improvement Permit with plat valid without expiration. Improvement Permit with site visit valid for sixty months. Authorization to Construct is valid for a period equal to that of Improvement Permit – not to exceed sixty months.

Signed: Jennifer Sherrill date

Installed by: BRENT GALLIHER

Improvement Permit by: [signature] RS date 10-17-01

Operation Permit by: [signature] RS date 12-5-01

Authorization to Construct by: [signature] RS date 10-17-01

Existing System Inspection by date

HEALTH DEPT COPY (WHITE)

The proposed garage addition does not appear to impact the existing septic system.

**NOTE:

[signature] R.S.

Date: 27 Aug 09

ICHD-Environmental Health Division

APR. 5, 1989 23:13