IREDELL COUNTY HEALTH DEPARTMENT

STATESVILLE 704-878-5305 MOORESVILLE 704-664-5281

IMPROVEMENT PERMIT / AUTHORIZATION TO CONSTRUCT / OPERATION PERMIT / EXISTING SYSTEM INSPECTION

PERMIT# Farm use No permit PIN# DATE 4-18-00

OWNER OR CONTRACTOR Steven Henry PHONE: Business Home 873-9234

ADDRESS 300 Block

LOCATION ~~East~~ 64 East TR Bangooth TR mill Garden 1.2 mi TL Gravel Dr. at end Left

SUBDIVISION BLOCK / SECTION LOT LOT AREA 4 Acres SITE CLASS P3 DESIGN FLOW 100 L.T.A.R. .25

Septic Tank: 1000 Gallons; STB 1017 Date 2-10-2000

Pump Tank: Gallons; PT Date

Pump Make: Model Serial No

Nitrification Field: No Fields 1 Square Feet 420 Linear Feet 140

No Lines 2 Trench Width 36" Max Trench Bottom Depth 34" Gravel Depth 12"

☒ New System ☐ Repair System Type: I II III IV V VI

System Description: Conv. Gravity

Repair System Description:

Maintenance Agreement Required: ☐ Yes ☒ No

☐ House/Mod. Home No. Bedrooms

☐ Mobile Home No. Bathrooms

☐ Business No. Employees 4

☒ Other Farm Bldg / Bath


☐ Slab ☐ Crawl Space ☐ Basement w/plumbing ☐ Basement wo/plumbing

Water Supply:
☒ Individual
☐ Public
☐ Community


Comments/Conditions:

Comments/Conditions:

INITIAL SITE SKETCH

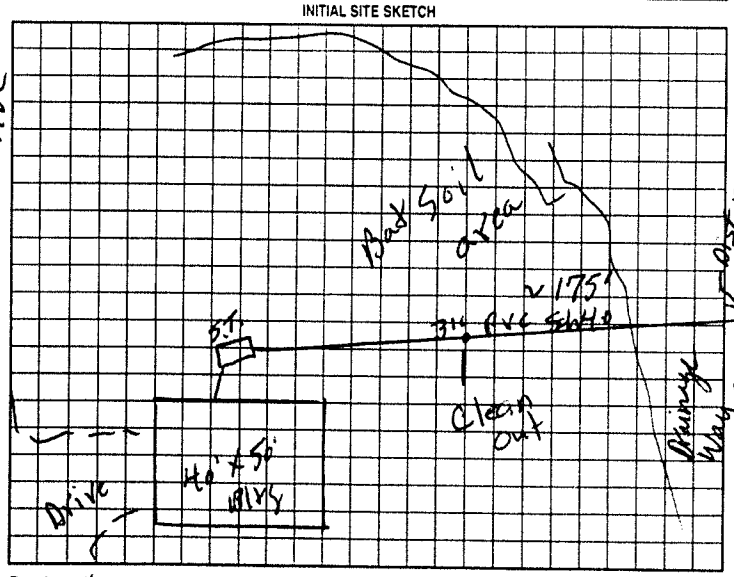

AS BUILT SKETCH

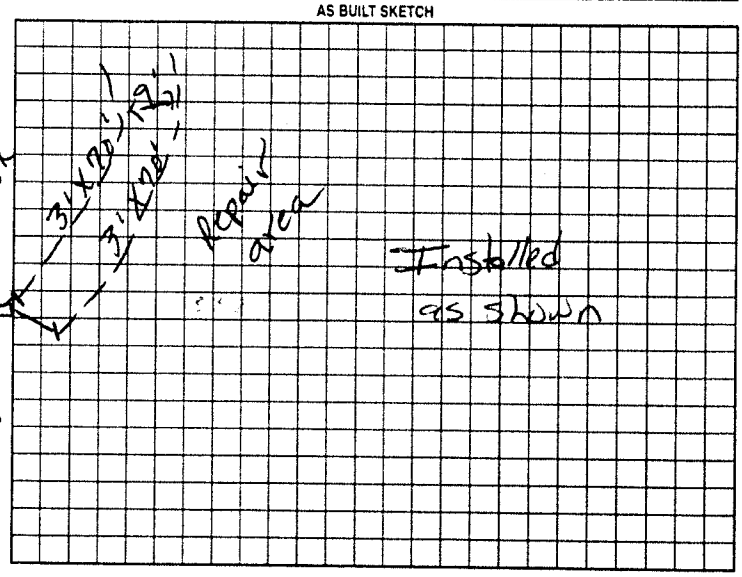

Permit can be suspended or revoked if any false information is supplied toward securing the permit/any unauthorized changes are made to the site/any unauthorized changes are made in the installation of the system. Improvement Permit with plat valid without expiration. Improvement Permit with site plan valid for sixty months. Authorization to Construct is valid for a period equal to that of Improvement Permit - not to exceed sixty months.

Signed: X Steven Henry date

Improvement Permit by: P. C. Moore date 4-18-00

Authorization to Construct by: P. C. Moore date 4-18-00

Installed by: Brent Gallimore

Operation Permit by: Mat Ouf RS date 6-13-00

Existing System Inspection by: date

HEALTH DEPT. COPY: WHITE OWNER COPY (FINAL) YELLOW OWNER COPY (INITIAL) PINK