IREDELL COUNTY HEALTH DEPARTMENT

STATESVILLE 704-878-5305 MOORESVILLE 704-664-5281

IMPROVEMENT PERMIT / AUTHORIZATION TO CONSTRUCT / OPERATION PERMIT / EXISTING SYSTEM INSPECTION

PERMIT# 131765 PIN# 4774701830 DATE 12-13-05

OWNER OR CONTRACTOR Kenneth Wilcox PHONE: Business 704-200-5782 Home 704-873-7593

ADDRESS 289 SEVENS SPRINGS LOOP STATESVILLE NC 28625

LOCATION 64 EAST (E) BALLYHOAK (R) MILLS GARDEN (L) ATSON # 686

SUBDIVISION _____ BLOCK / SECTION _____ LOT _____ LOT AREA 15.1AC SITE CLASS. PS DESIGN FLOW 480 L.T.A.R. .25

Septic Tank: 1000 Gallons; STB 825 Date 3-20-06
Pump Tank: 1000 Gallons; PT 302 Date 3-19-06
Pump Make: _____ Model N-150-002 Serial No Zoeller
Nitrification Field: No Fields 1 Square Feet EVA 1920 Linear Feet 480
No Lines 4 Trench Width 36" Max Trench Bottom Depth 36" Gravel Depth N/A

☒ New System ☐ Repair System Type: I, II, (III) IV, V, VI
System Description: PUMP 25% REDUCT
Repair System Description: LP 50% REDUCT
Maintenance Agreement Required: ☐ Yes ☒ No

☐ House/Mod. Home No. Bedrooms 4
☐ Mobile Home No. Bathrooms ____
☐ Business No. Employees ____
☐ Other _____

☐ Slab ☐ Crawl Space ☒ Basement w/plumbing ☐ Basement wo/plumbing

Water Supply: ☐ Individual ☒ Public ☐ Community

Comments:/Conditions: (1) BUILDER SAID TWO LOTS ARE COMBINED

Comments:/Conditions:
Need Lot Lot Letter
Pump tank Risers
Septic tank Risers

INITIAL SITE SKETCH

INSTALL SYSTEM ACCORDING TO LSS SPECIFICATIONS SUBMITTED BY ASHLY ROLLINS, LSS

AS BUILT SKETCH

Pressure head Checked 8-4-06
Bells
Lines
Maintenance agreement (N)


Permit can be suspended or revoked if any false information is supplied toward securing the permit/any unauthorized changes are made to the site/any unauthorized changes are made in the installation of the system. Improvement Permit with plat valid without expiration. Improvement Permit with site plan valid for sixty months. Authorization to Construct is valid for a period equal to that of Improvement Permit – not to exceed sixty months.

Signed: _____ date 12-13-05 Installed by: Rowan Surveying

Improvement Permit by: _____ date 12-13-05 Operation Permit by: _____ date 4-18-07

Authorization to Construct by: _____ date 12-13-05 Existing System Inspection by: _____ date _____

HEALTH DEPT. COPY: WHITE OWNER COPY (FINAL): YELLOW OWNER COPY (INITIAL): PINK

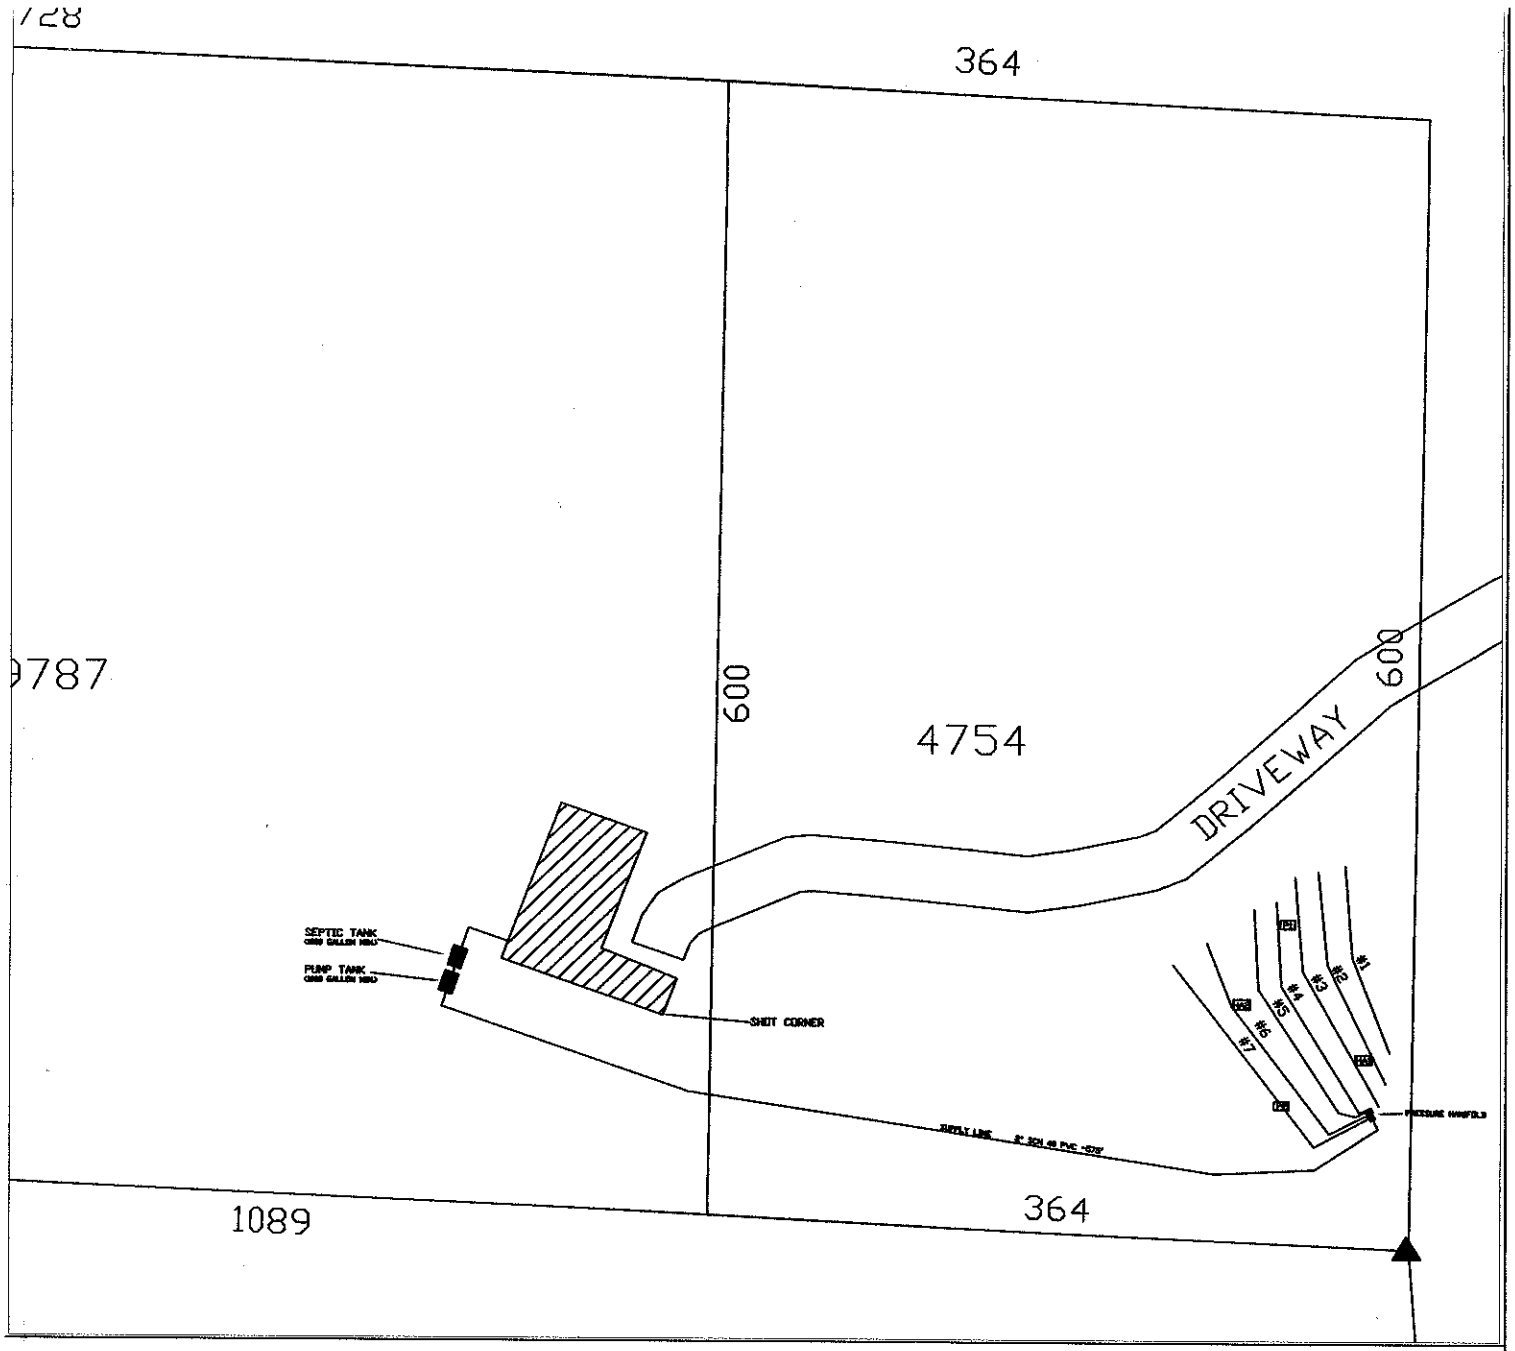

LEGEND

- Areas contain soils with 24 inches or more of useable material and have potential for conventional, modified conventional and low-pressure pipe (lpp) septic systems.
- Unsuitable areas.
- System lines.
- Repair lines.
- Temporary Bench Mark (TBM)
- Well Location.

GRAPHIC SCALE

1" = 100'

100 0 100 200

FOR PRELIMINARY PLANNING PURPOSES ONLY. ALL LOTS WILL REQUIRE FINAL APPROVAL BY THE COUNTY HEALTH DEPARTMENT ON A LOT BY LOT BASIS. THIS MAP SHOULD BY USED AS A GENERAL GUIDE, SOME ADJUSTMENTS WILL BE NECESSARY IN THE FIELD DUE TO SOIL VARIABILITY AND COMPLEX TOPOGRAPHIC FEATURES. THIS MAP ONLY REFLECTS EXISTING SOIL SUITABILITY FOR ON-SITE SEPTIC TANK SYSTEMS.

PLEASE REFER TO ATTACHED SOIL REPORT FOR ADDITIONAL SITE SPECIFIC INFORMATION

ROLLANS SOIL & ENVIRONMENTAL SERVICES
2120 GRAHAM ROAD
MOUNT ULLA, NC 28125
PHONE/FAX: (704) 278-0989
ASHLEY ROLLANS, NC LICENSED SOIL SCIENTIST
MOBILE: (704) 746-5046
EMAIL: ROLLANSFORTC@AOL.COM

MAP TITLE: SITE PLAN & DRAINFIELD AREAS

PROJECT NAME: KEN WILCOX

LOCATION/DATE: 606 MILLS GARDEN ROAD, IREDELL COUNTY, NORTH CAROLINA, NOVEMBER 2005

JOB # : 01-1165
FILE: C:\JOBS\01-1165
PROJECT MGR.: S.A.R.
FIELD WORK: S.A.R. and C.B.F.
DRAWN BY: S.A.R.