IREDELL COUNTY HEALTH DEPARTMENT

Statesville Office (704) 878-5305 Mooresville Office (704) 660-3625 PERMIT # 219734

IMPROVEMENT PERMIT / AUTHORIZATION TO CONSTRUCT / OPERATION PERMIT / EXISTING SYSTEM

PIN # 4774740113

APPLICANT: Freedom Homes APPLICANT ADDRESS: 1124 Charlotte Hwy Troutman NC

SITE ADDRESS: 518 Mills Garden Rd Statesville, NC PHONE: 704 528-7960 ALT. PHONE: 704 876 5866


SITE DIRECTIONS: I-40 East to exit 154 TR Old Mocksville Rd TL US-64E TR Barn Oak take 2nd right Mills Garden Rd on

SUBDIVISION: Mills Garden Farms SECTION: — LOT # 60 LOT AREA: 1.17 Acres DESIGN FLOW: 480 gpd L.T.A.R.: .3 right

Septic Tank	1000	(gal)	STB 760	Date 6-7-16	☒ New System	☐ Repair	☐ Expansion	System Type: I II III IV V VI	☒ Residence	No. Bedrooms	4	Water Supply
Pump Tank		(gal)	PT	Date	System Description:	Gravity - 25% Reduction			☐ Business	No. Persons	8	☒ Private
Pump Make		Model		Serial #	Repair System Description:	Same			☐ Other	No. Employees		☐ Public
# Nitrification Fields	1	# Lines	4	Linear Ft: 400ft	Maintenance Agreement Required:	☐ YES	☒ NO		☐ Slab	☒ Crawl Space		☐ Community
Trench Width	36"	Max. Trench Bottom Depth	34"	Gravel Depth N/A	☒ GRAVITY	☐ PRESSURE			☐ Basement w/plumbing	☐ Basement w/o plumbing		

Comments / Conditions: Divert Stormwater, Surface Water Away from Septic System

INITIAL SITE SKETCH

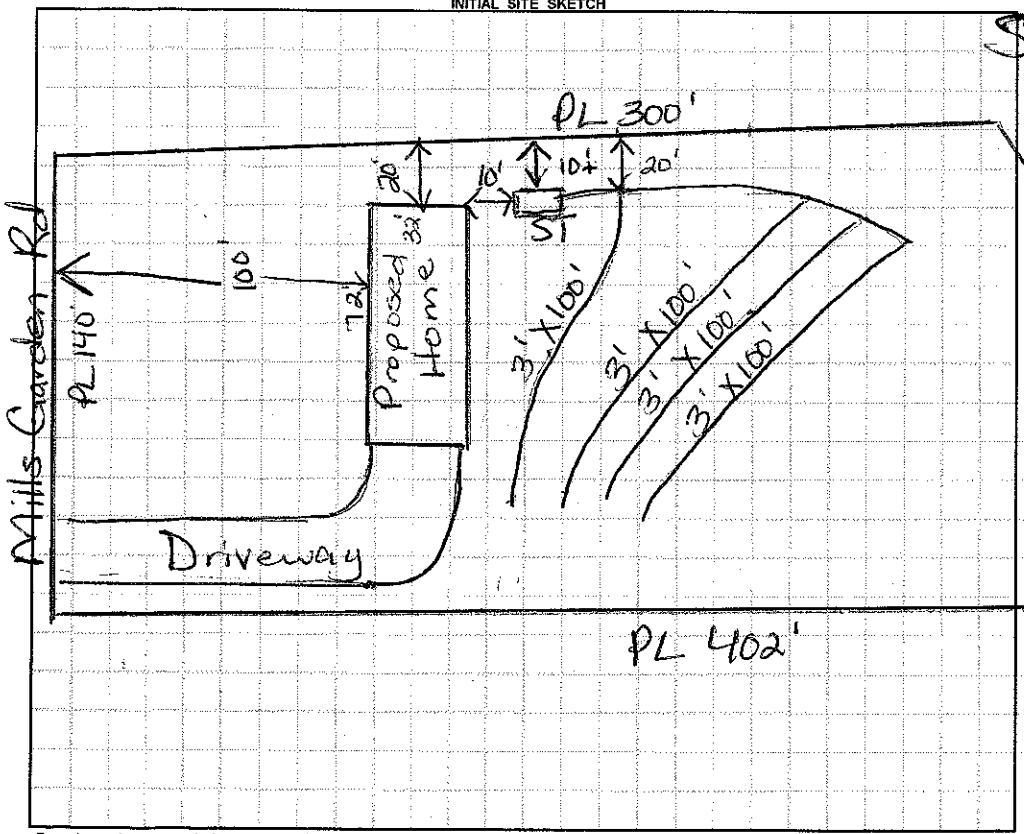

AS BUILT SKETCH

Scale 1:60

Permit can be suspended or revoked if any false information is supplied toward securing the permit / any unauthorized changes are made to the site / any unauthorized changes are made in the installation of the system. **CONTACT A LOCATOR SERVICE PRIOR TO ANY EXCAVATION**

☐ **IMPROVEMENT PERMIT** *with plat valid without expiration.* ☒ **IMPROVEMENT PERMIT** *with site plan valid for 60 mos.* ☐ **AUTHORIZATION TO CONSTRUCT** *valid for period equal to IMPROVEMENT PERMIT--not to exceed 60 mo.*

Owner / Applicant Signature: Stephen Ash Date: 8-9-16 Installed by: Abee's Carolina

IMPROVEMENT PERMIT by: Maria H. Dotson RS Date: 8/8/16 OPERATION PERMIT by: Maria Dotson Date: 8/26/16

AUTHORIZATION TO CONSTRUCT by: Maria Dotson RS Date: 8/9/16 Existing System Inspected by: Date:

Health Dept. Copy - WHITE Applicant (Final Approval) - YELLOW Applicant (Conditional Approval) - PINK