IREDELL COUNTY HEALTH DEPARTMENT

Statesville Office (704) 878-5305 Mooresville Office (704) 660-3625 PERMIT # 208361

IMPROVEMENT PERMIT / AUTHORIZATION TO CONSTRUCT / OPERATION PERMIT / EXISTING SYSTEM

PIN # 4774743014

APPLICANT: Award Pools & Spas APPLICANT ADDRESS: 411 Brawley Rd.

SITE ADDRESS: 532 Garden Valley Rd. PHONE: 704-746-9937 ALT. PHONE: N/A


SITE DIRECTIONS: Hwy 64 E TR Barry Oak TR Mills Garden

SUBDIVISION: Mills Garden Farms SECTION: N/A LOT # 8 LOT AREA: 0.78 acres DESIGN FLOW: 480 gpd L.T.A.R.: 0.25

Septic Tank	Existing	(gal)	STB		Date		☑ New System ☐ Repair ☐ Expansion	System Type: I II (III) IV V VI	☑ Residence	No. Bedrooms	4	Water Supply
Pump Tank		(gal)	PT		Date		System Description:	25% Reduction → Existing	☐ Business	No. Persons	8	☐ Private
Pump Make			Model		Serial #		Repair System Description:	Low Pressure PPBPS	☐ Other	No. Employees		☑ Public
# Nitrification Fields	1	# Lines	6	Linear Ft:	Existing		Maintenance Agreement Required:	☐ YES ☑ NO	☐ Slab	☑ Crawl Space		☐ Community
Trench Width	Existing	Max. Trench Bottom Depth	6'	Gravel Depth	N/A		☑ GRAVITY	☐ PRESSURE	☐ Basement w/ plumbing		☐ Basement w/o plumbing	

Comments / Conditions: - The water line & power line shall be relocated to meet setbacks to repair area when and if a repair installation is deemed necessary!

INITIAL SITE SKETCH

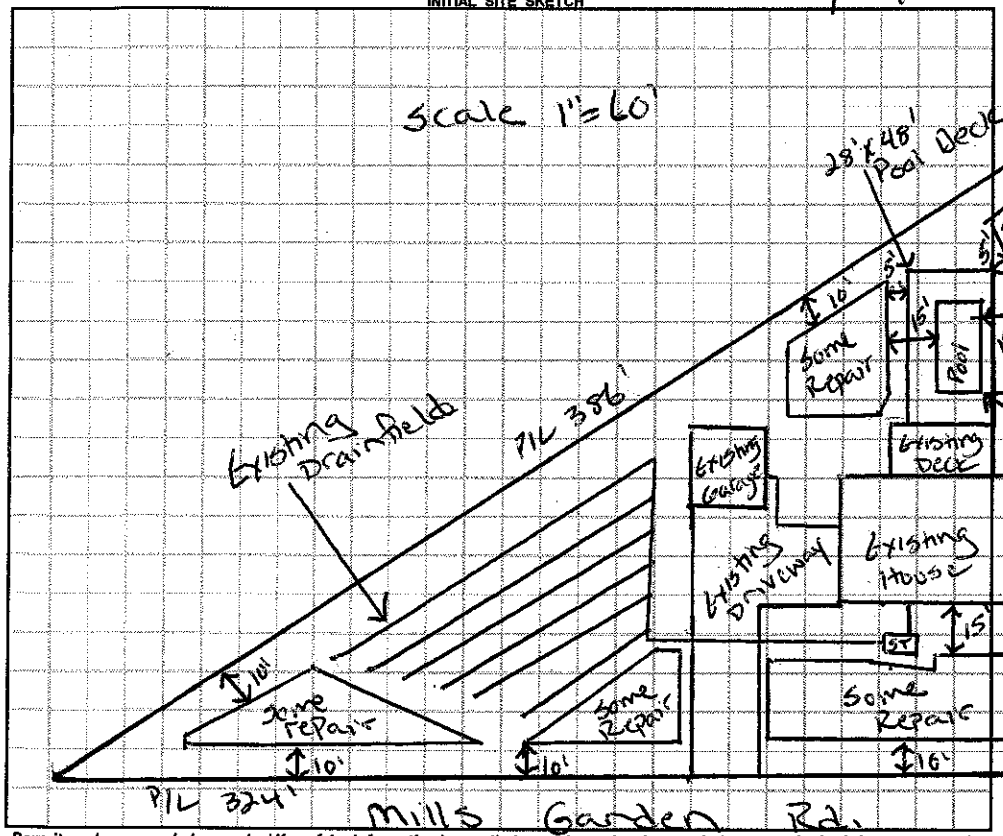

AS BUILT SKETCH

- The purpose of this permit is to relocate the repair area to accommodate the proposed pool deck & pool.

Permit can be suspended or revoked if any false information is supplied toward securing the permit / any unauthorized changes are made to the site / any unauthorized changes are made in the installation of the system. **CONTACT A LOCATOR SERVICE PRIOR TO ANY EXCAVATION**

☐ **IMPROVEMENT PERMIT** *with plat valid without expiration.* ☑ **IMPROVEMENT PERMIT** *with site plan valid for 60 mos.* ☑ **AUTHORIZATION TO CONSTRUCT** *valid for period equal to IMPROVEMENT PERMIT--not to exceed 60 mo.*

Owner / Applicant Signature: Date: 3-6-15 Installed by:

IMPROVEMENT PERMIT by: Date: 3-4-15 OPERATION PERMIT by: Issued by James Stewart Date: 3-30-06

AUTHORIZATION TO CONSTRUCT by: Date: 3-4-15 Existing System Inspected by: Date:

Health Dept. Copy - WHITE Applicant (Final Approval) - YELLOW Applicant (Conditional Approval) - PINK