IREDELL COUNTY HEALTH DEPARTMENT

STATESVILLE 704-878-5305 (2) MOORESVILLE 704-664-5281

IMPROVEMENT PERMIT / AUTHORIZATION TO CONSTRUCT / OPERATION PERMIT / EXISTING SYSTEM INSPECTION

(1)

PERMIT# 120726 PIN# 4774-74-3331 DATE 5-26-04

OWNER OR CONTRACTOR JAMES CHILDRESS PHONE: Business 704-872-2965 Home 704-872-9768

ADDRESS 822 CHERRY STREET, STATESVILLE, NC 28677

LOCATION US 64 EAST, TR BARRY OAK ROAD, TR MILLS GARDEN ROAD, 1.6 MILES ON LEFT, 520' OFF ROAD

SUBDIVISION MILLS GARDEN FARM LOCK / SECTION _____ LOT 10 LOT AREA 3.78 ACRES SITE CLASS. PS DESIGN FLOW 360 L.T.A.R. 0.25 GPD/FT²

Septic Tank: 1000 Gallons; STB 1012 Date 4-1-04
Pump Tank: _____ Gallons; PT _____ Date _____
Pump Make: _____ Model _____ Serial No. _____
Nitrification Field: No. Fields 1 Square Feet 1440 Linear Feet 480
No. Lines FOUR Trench Width 36" Trench Bottom Depth 36" Gravel Depth 12"

☑ New System ☐ Repair System Type: I, II, III, IV, V, VI
System Description: CONVENTIONAL, GRAVITY
Repair System Description: CONVENTIONAL, GRAVITY
Maintenance Agreement Required: ☐ Yes ☑ No


☑ House/Mod. Home No. Bedrooms 3
☐ Mobile Home No. Bathrooms 2
☐ Business No. Employees ____
☐ Other _____
☐ Slab ☐ Crawl Space ☑ Basement w/plumbing ☐ Basement wo/plumbing

Water Supply: ☐ Individual ☑ Public ☐ Community


Comments:/Conditions: INSTALL LINE ON CONTOUR IN TRENCHES DUG 36" DEEP,

Comments:/Conditions: SEPTIC TANK WITH MARKER INSTALLED USING "TUFFTITE" FILTER

INITIAL SITE SKETCH

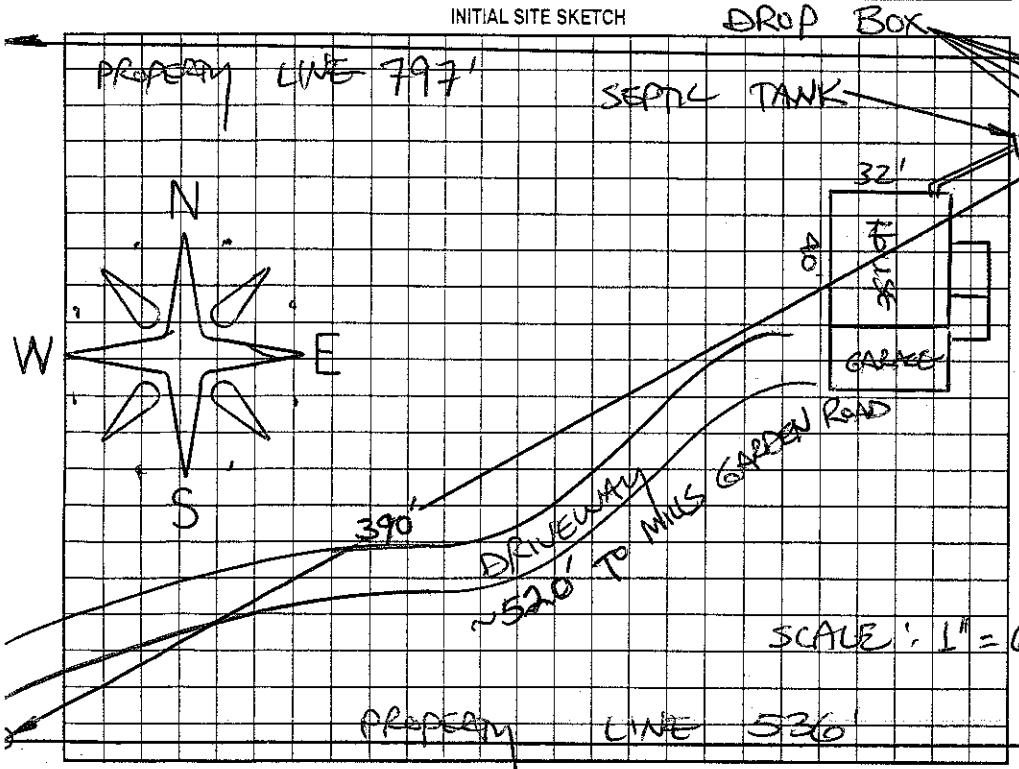

AS BUILT SKETCH

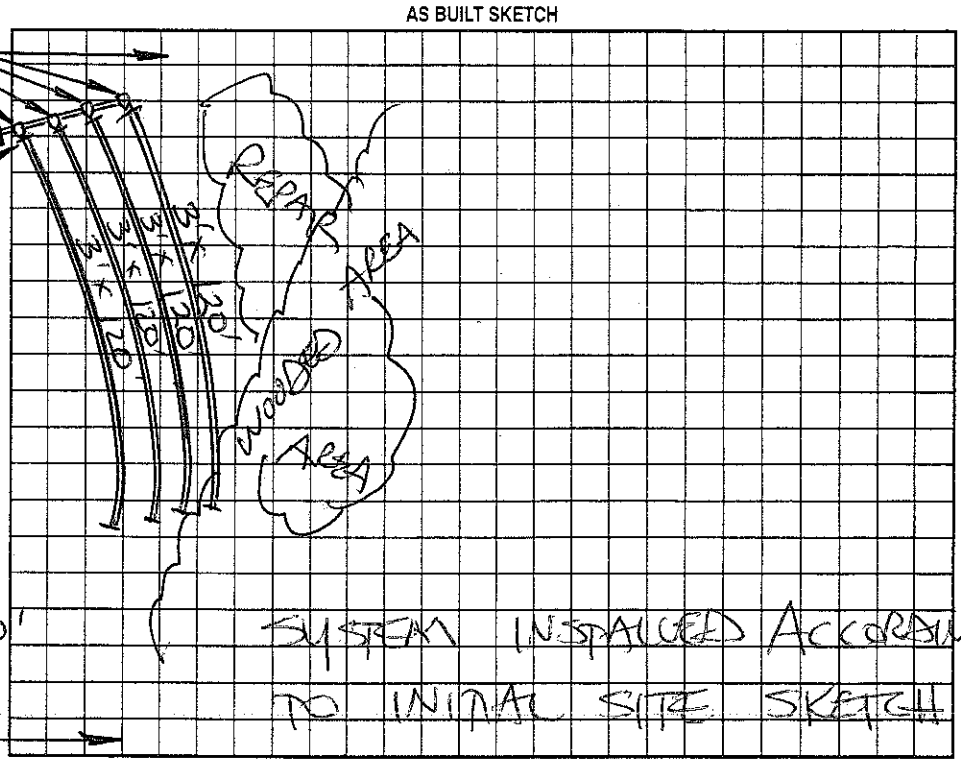

Permit can be suspended or revoked if any false information is supplied toward securing the permit/any unauthorized changes are made to the site/any unauthorized changes are made in the installation of the system. Improvement Permit with plat valid without expiration. Improvement Permit with site plan valid for sixty months. Authorization to Construct is valid for a period equal to that of Improvement Permit – not to exceed sixty months.

Signed: James Childress date 5-26-04 Installed by: DAVID YOUNTZ

Improvement Permit by: STEVE HENDRICK date 5-26-04 Operation Permit by: STEVE HENDRICK date 9-11-05

Authorization to Construct by: STEVE HENDRICK date 5-26-04 Existing System Inspection by: _____ date _____

HEALTH DEPT. COPY: WHITE OWNER COPY (FINAL): YELLOW OWNER COPY (INITIAL): PINK