IREDELL COUNTY HEALTH DEPARTMENT

STATESVILLE 704-878-5305 MOORESVILLE 704-664-5281

IMPROVEMENT PERMIT / AUTHORIZATION TO CONSTRUCT / OPERATION PERMIT / EXISTING SYSTEM INSPECTION

PERMIT# 92824 PIN# 4774 64 3573 PT DATE 11/16/00

OWNER OR CONTRACTOR Dean Lankford PHONE: Business _____ Home 876-0269

ADDRESS 550 Jane Sowers Rd Statesville NC 28625

LOCATION 64E, R Barry Oak, R Mills Garden, on Lt.

SUBDIVISION Mills Garden Farms BLOCK / SECTION _____ LOT 13 LOT AREA 8.65AC SITE CLASS PS DESIGN FLOW 480 L.T.A.R. 0.5

Septic Tank: 1000 Gallons: STB 1007 Date 3-1-01
Pump Tank: _____ Gallons: PT _____ Date _____
Pump Make: _____ Model _____ Serial No. _____
Nitrification Field: No Fields 1 Square Feet 1600 Linear Feet 533
No Lines 4 @ 133' Trench Width 36" Max Trench Bottom Depth 36" Gravel Depth 12"

☒ New System ☐ Repair System Type: I. II. III. IV. V. VI
System Description: Gravity Conv.
Repair System Description: Same
Maintenance Agreement Required: ☐ Yes ☒ No
☐ Slab ☒ Crawl Space ☐ Basement w/plumbing ☐ Basement wo/plumbing


☒ House/Mod. Home No. Bedrooms 3
☐ Mobile Home No. Bathrooms 3½
☐ Business No. Employees _____
☐ Other _____

Water Supply:
☐ Individual
☒ Public
☐ Community

Comments:/Conditions:

Comments:/Conditions: POLYLOK FILTER & RISERS INSTALLED AS SHOWN

INITIAL SITE SKETCH NOT TO SCALE

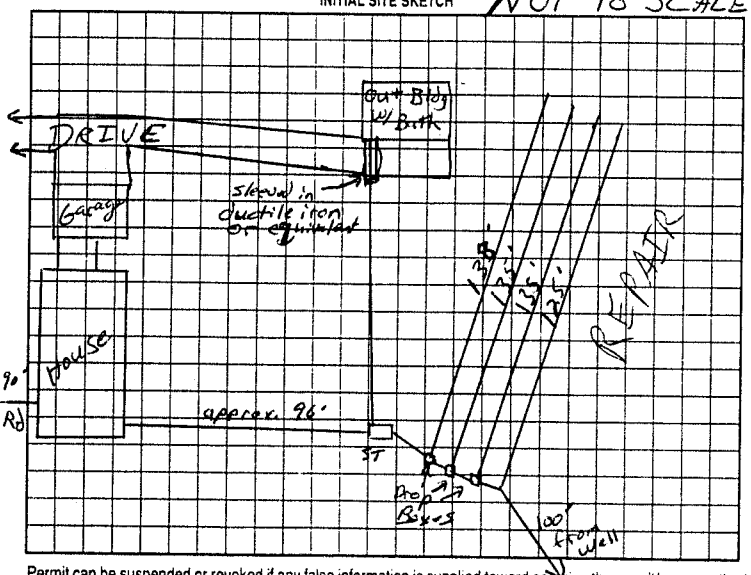

AS BUILT SKETCH

Permit can be suspended or revoked if any false information is supplied toward securing the permit/any unauthorized changes are made to the site/any unauthorized changes are made in the installation of the system. Improvement Permit with plat valid without expiration. Improvement Permit with site plan valid for sixty months. Authorization to Construct is valid for a period equal to that of Improvement Permit – not to exceed sixty months.

Signed: Dean Lankford date 11/21/00 Installed by: JODY TRAVIS

Improvement Permit by: RSE date 11/16/00 Operation Permit by: RSE date 7-17-01

Authorization to Construct by: RSE date 11/16/00 Existing System Inspection by: _____ date _____

HEALTH DEPT COPY. WHITE OWNER COPY (FINAL). YELLOW OWNER COPY (INITIAL). PINK