IREDELL COUNTY HEALTH DEPARTMENT

STATESVILLE 704-878-5305 MOORESVILLE ~~704-664-5281~~ ad

IMPROVEMENT PERMIT / AUTHORIZATION TO CONSTRUCT / OPERATION PERMIT / EXISTING SYSTEM INSPECTION

PERMIT # 158967 PIN # 4774-74-3894 DATE 2 July 10

OWNER or APPLICANT Dean Lankford PHONE: ~~Business~~ Cell (704) 682-9730 Home:

OWNER or APPLICANT ADDRESS 493 Mills Garden Rd. Statesville

LOCATION / DIRECTIONS N. 64E TR Bobby Oaks Rd. TR Mills Garden Rd. 1st on left.

SUBDIVISION BLOCK / SECTION LOT # 13 LOT AREA 8.66Ac DESIGN FLOW 490gpd L.T.A.R. 0.7

Existing

Septic Tank 1000 Gallons: STB Date

Pump Tank Gallons: P T Date

Pump Make Model Serial #

Nitrification Field No Fields 1 No Lines 4 Linear Feet 535

Trench Width 36" Max. Trench Bottom Depth 36" Gravel Depth 12"

☐ New System ☐ Repair ☐ Expansion System Type I (II) III IV V VI

System Description: Exist. Conventional

Repair System Description:

Maintenance Agreement Required ☐ YES ☒ NO

☑ GRAVITY ☐ PRESSURE

☑ Residence No. Bedrooms 3

☑ Business No. Persons

☐ Other No. Employees 3

☐ Slab ☑ Crawl Space

☐ Basement w/plumbing ☐ Basement w/o plumbing


Water Supply: ☐ Private ☑ Public ☐ Community

Comments / Conditions

Comments / Conditions

INITIAL SITE SKETCH

AS BUILT SKETCH

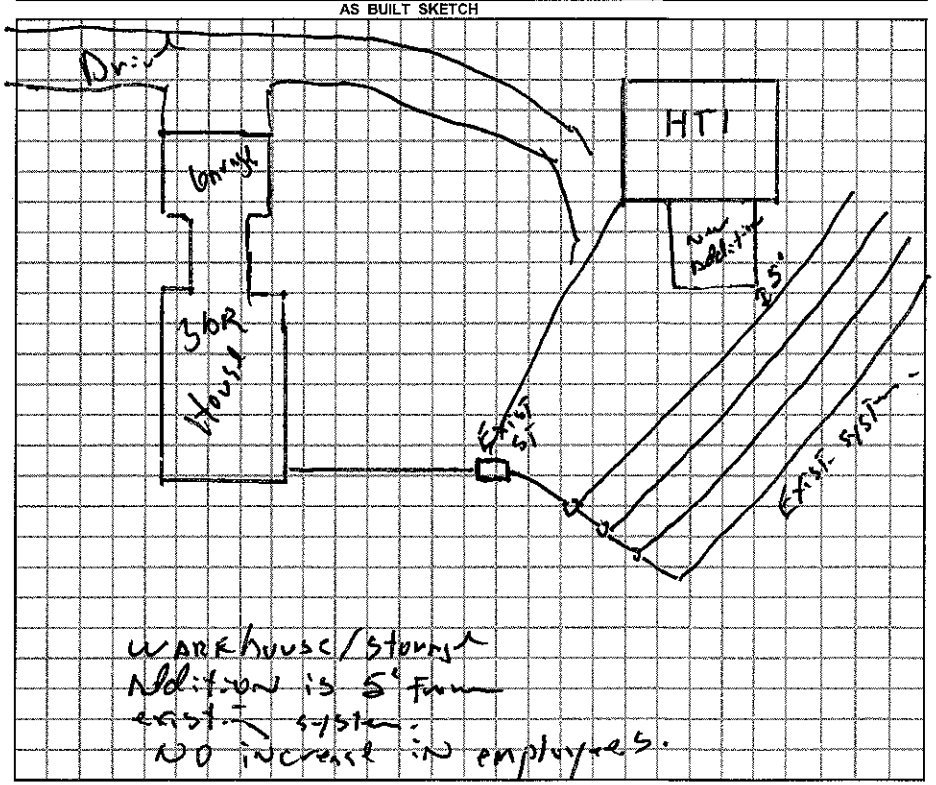

Warehouse/Storage
Addition is 5' from exist. system
No increase in employees.

Permit can be suspended or revoked if any false information is supplied toward securing the permit / any unauthorized changes are made to the site / any unauthorized changes are made in the installation of the system.

☐ *IMPROVEMENT PERMIT w / plat valid without expiration.* ☐ *IMPROVEMENT PERMIT w / site plan valid for 60 mos.* ☐ *AUTHORIZATION TO CONSTRUCT valid for period equal to IMPROVEMENT PERMIT-not to exceed 60 mo.*

Owner / Applicant Signature: Dean Lankford Date 8/2/10

Improvement Permit by: Date

Authorization to Construct by: Date

YOU SHOULD CONTACT A LOCATOR SERVICE PRIOR TO ANY EXCAVATION.

Installed by:

Operation Permit by: Date:

Existing System Inspected by: R.S. Date: 2 July 10

WHITE COPY Environmental Health YELLOW COPY (Final) Owner / Applicant PINK COPY (Initial) Owner / Applicant