IREDELL COUNTY HEALTH DEPARTMENT (CI)

STATESVILLE 704-878-5305 MOORESVILLE 704-664-5281

IMPROVEMENT PERMIT / AUTHORIZATION TO CONSTRUCT / OPERATION PERMIT / EXISTING SYSTEM INSPECTION

PERMIT# 133455 PIN# 4774845647 02250 DATE 6-2-06

OWNER OR APPLICANT Bobby Kurriker PHONE: Business 704 872 5884 Home

ADDRESS Wilcox Ln.

LOCATION 64E (R) on Barry Oaks (R) on Mills Garden (R) on Wilcox lane Property on left

SUBDIVISION n/a BLOCK / SECTION LOT LOT AREA 169.78 Acres SITE CLASS. PS DESIGN FLOW 240 L.T.A.R. .2

Septic Tank: 1000 Gallons; STB 1012 Date 11-14-06
Pump Tank: Gallons; PT Date
Pump Make: Model Serial No.
Nitrification Field: No Fields 1 Square Feet 1200 Linear Feet 300
No Lines 3 Trench Width 36" Max Trench Bottom Depth 36" Gravel Depth

☒ New System ☐ Repair ☐ Expansion System Type: I (II) III IV V VI
System Description: 25% Reduction
Repair System Description: 25% Reduction
Maintenance Agreement Required: ☐ Yes ☒ No

☐ House/Mod. Home ☒ Mobile Home ☐ Business ☐ Other
No. Bedrooms 2 No. Persons No. Employees


Water Supply: ☐ Individual ☒ Public ☐ Community

☒ Gravity ☐ Pressure ☐ Slab ☒ Crawl Space ☐ Basement w/plumbing ☐ Basement wo/plumbing

Comments:/Conditions:

Comments:/Conditions:

INITIAL SITE SKETCH

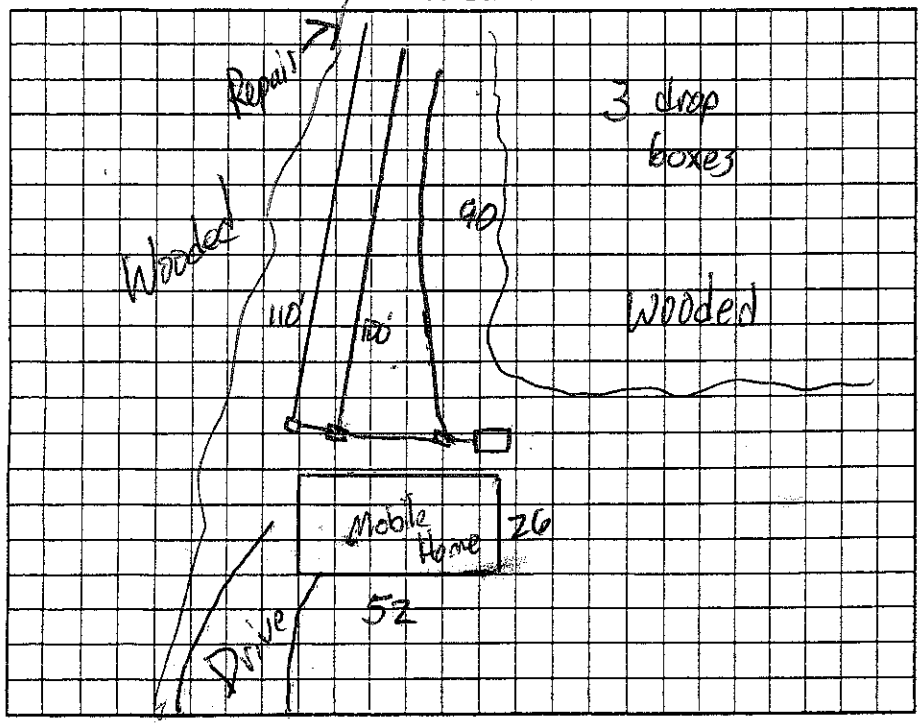

AS BUILT SKETCH

Permit can be suspended or revoked if any false information is supplied toward securing the permit/any unauthorized changes are made to the site/any unauthorized changes are made in the installation of the system. Improvement Permit with plat valid without expiration. ☐ Improvement Permit with site plan valid for sixty months ☐ Authorization to Construct is valid for a period equal to that of Improvement Permit – not to exceed sixty months.

Signed: Bobby Kurriker date 6/6/12

Improvement Permit by: James date 6-2-06

Authorization to Construct by: James date 6-2-06

Installed by: Dale Wingler

Operation Permit by: James date 5-1-07

Existing System Inspection by: date

HEALTH DEPT. COPY: WHITE OWNER COPY (FINAL): YELLOW OWNER COPY (INITIAL): PINK