704 23 300' Rick Wilson 704-902-2343 Sammy Reavis 704-546-2424 / 704-380-0903

IREDELL COUNTY HEALTH DEPARTMENT

STATESVILLE 704-878-5305 MOORESVILLE 704-664-5281

IMPROVEMENT PERMIT / AUTHORIZATION TO CONSTRUCT / OPERATION PERMIT / EXISTING SYSTEM INSPECTION

PERMIT# 132037 PIN# 4774-83-4568 813-728-7606 CELL# DATE 10-24-05

OWNER OR CONTRACTOR PATRICK & LISA AHEARN PHONE: Business 813-907-3382 Home 813-728-7616

ADDRESS 8706 SHENANDOAH RUN (FLORIDA) WESLEY CHAPEL FL 33544

LOCATION 64 EAST (R) BARRY OAK (R) MILLS GARDEN (L) IN FIELD OFF ROAD ACROSS FROM BOX # 566

SUBDIVISION ~~N/A~~ Bowed Oakes / SECTION N/A LOT ~~N/A~~ 1 LOT AREA 8.016 SITE CLASS. PS DESIGN FLOW 480 L.T.A.R. .25

Septic Tank: 1000 Gallons; STB 760 Date 4-25-06
Pump Tank: 1000 Gallons; PT 363 Date 6-5-06
Pump Make: ZOELLER Model N151-E Serial No.
Nitrification Field: No Fields 1 Square Feet ED=1920' Linear Feet 480'
No Lines 4x120' Trench Width 36" Max Trench Bottom Depth 36" (MIN/MAX) Gravel Depth N/A

☒ New System ☐ Repair System Type: I, II, (III), IV, V, VI
System Description: PUMP 25% REDUCT
Repair System Description: LP 50% REDUCT
Maintenance Agreement Required: ☐ Yes ☒ No

☒ House/Mod. Home ☐ Mobile Home ☐ Business ☐ Other
No. Bedrooms 4 No. Bathrooms 3½ No. Employees


Water Supply: ☐ Individual ☒ Public ☐ Community

☐ Slab ☒ Crawl Space ☐ Basement w/plumbing ☐ Basement wo/plumbing

Comments:/Conditions: (1) NOTE MINIMUM & MAXIMUM TRENCH BOTTOM DEPTH IS 36" (2) INSTALL LINES ON CONTOURS & MAINTAIN SETBACKS (3) DIVERT SURFACE H2O AROUND SYSTEM ABOVE TRENCH DRAIN

Comments:/Conditions: (4) KEEP TRENCH DRAIN 22' ABOVE SYSTEM & 15' OFF SIDESLOPE OF SYSTEM, SUPPLY MUST BE 5' OFF TRENCH DRAIN. (5) CALL PRIOR TO INSTALLATION FOR SYSTEM PUMP SPECS IF NECESSARY.

INITIAL SITE SKETCH AS BUILT SKETCH

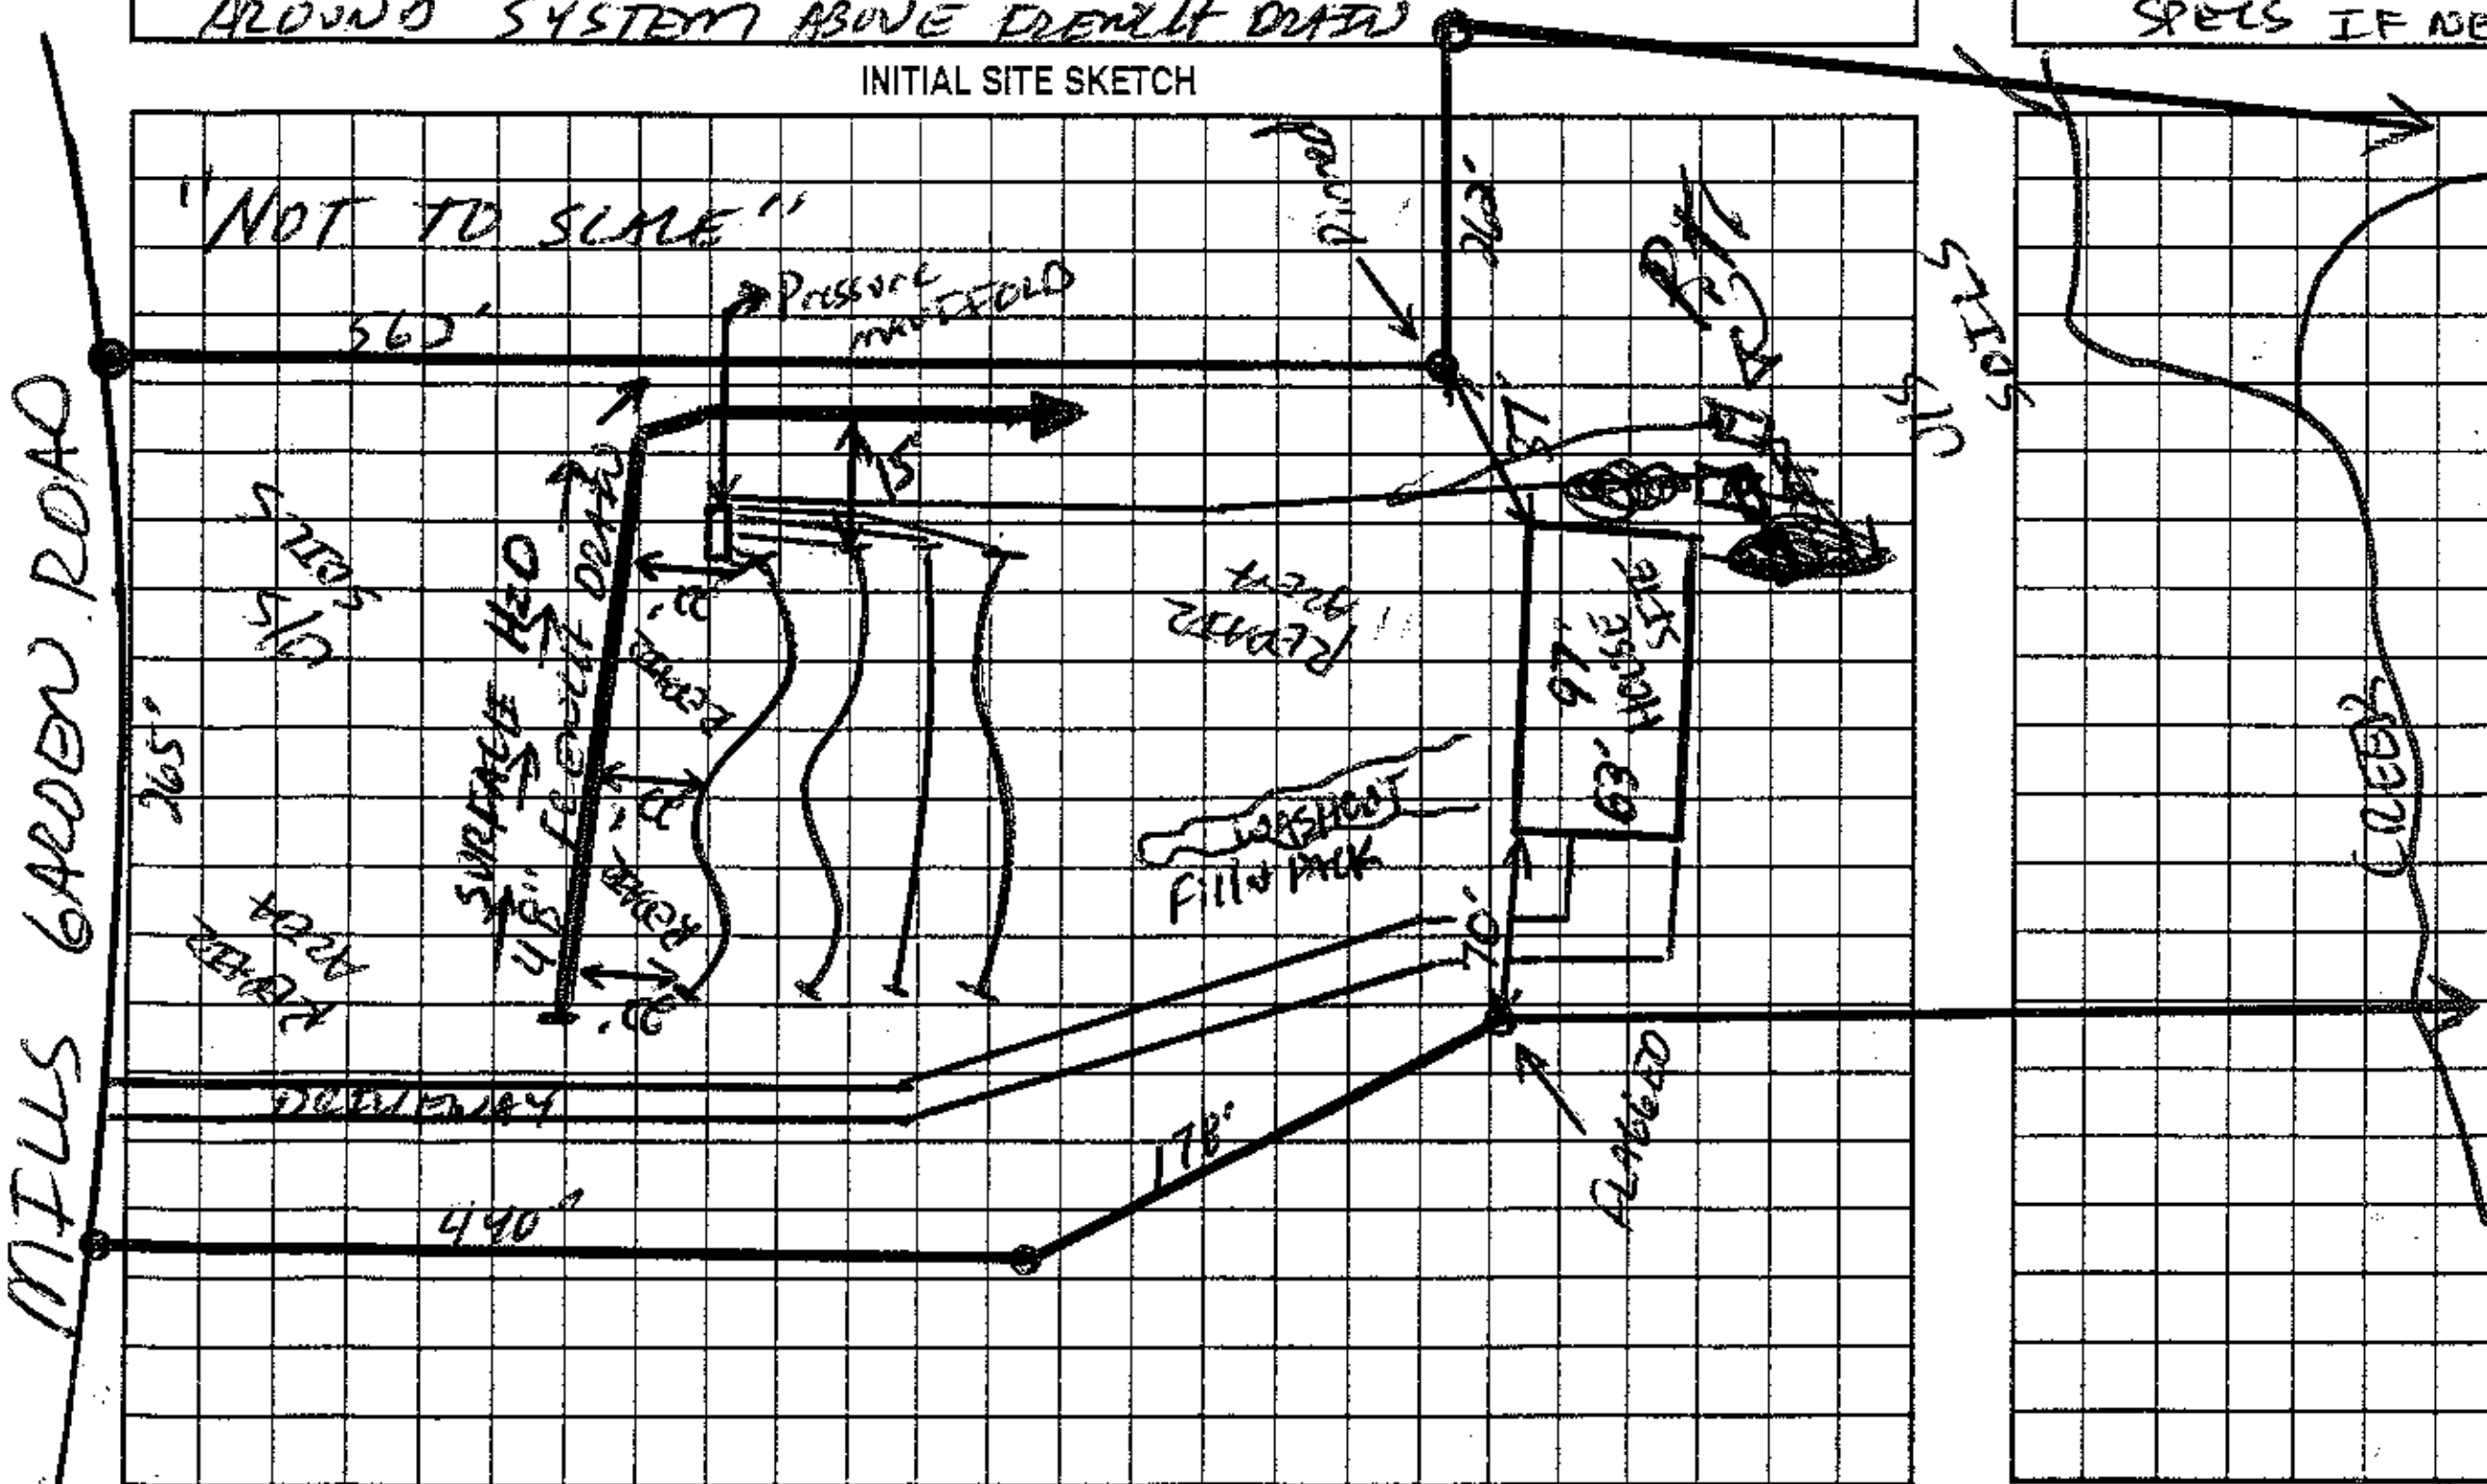

*ALARM IN GARAGE, ON RECEPT. CIRCUIT
*SYSTEM INSTALLED AS SHOWN.

1-29 = 115 3-29 = 115
2-29 = 115 4-29 = 115

	Date	Initials
Drain Lines Checked	8-21-06	ALC
Tanks Checked PARTIALLY	8-21-06	ALC
Pressure Manifold or Valve Box Checked	8-21-06	ALC
Pressure Head Set	8-22-06	PM
Electrical Checked	9-19-06	PM
Floats Set	9-19-06	PM
Alarm Checked	9-19-06	PM
Maintenance Contract Y (N)		

*NEEDS XTRA GRAVEL IN TRENCH DRAIN WITHIN 6" OF GRADE (OR CUT VERY LITTLE) PM

Permit can be suspended or revoked if any false information is supplied toward securing the permit/any unauthorized changes are made to the site/an[...] Permit with plat valid without expiration. Improvement Permit with site plan valid for sixty months. Authorization to Construct is valid for a period equal to that of Improvement Permit – not to exceed sixty months.

Signed: [signature] date 10-24-05 Installed by: SAMMY REAVIS

Improvement Permit by: [signature] PS date 10-24-05 Operation Permit by: [signature] date 09/19/06

Authorization to Construct by: [signature] PS date 10-24-05 Existing System Inspection by: date

HEALTH DEPT. COPY: WHITE OWNER COPY (FINAL): YELLOW OWNER COPY (INITIAL): PINK