48927

IREDELL COUNTY HEALTH DEPARTMENT

STATESVILLE 704-878-5305 MOORESVILLE 704-664-5281

IMPROVEMENT PERMIT / CERTIFICATE OF COMPLETION / OPERATION PERMIT / EXISTING SYSTEM INSPECTION

PROPERTY DESCRIPTION NO. 16948 DATE 9-29-93 TAX MAP NO. 5P-A-64

OWNER OR CONTRACTOR ~~[illegible]~~ Bill J. Hurt PHONE: Business Home 872-7822

ADDRESS Rt 1 Box 343A Sta

LOCATION 70E TL Elmwood Rd Sta TL Mills Garden Rd 500' TL Private Rd 500' on left

SUBDIVISION BLOCK / SECTION LOT LOT AREA 1 acre + SITE CLASS PS L.T.A.R. .25

Water Supply: ☑ Individual ☐ Community ☐ Public

Septic Tank: 1000 Gallons: STB Date

Pump Tank: 1000 Gallons: PT Date

Nitrification Field: No Fields 1 Square Feet 1500 Linear Feet 500

No Lines 5 Trench Width 36 Trench Depth 24 Gravel Depth 12

☑ New System ☐ Repair System Type: I. II. III. IV. V. VI

System Description: Conv. Pump

Repair System Description: " "

Maintenance Agreement Required: ☐ Yes ☐ No

☑ House/Mod. Home ☐ Mobile Home ☐ Business ☐ Other ~~Trailer~~

~~1440sf~~ 1400sf Sewer easement

No. Bedrooms 3 No. Bathrooms 2 No. Employees ~~office~~

Garbage Disposal: ☐ Yes ☑ No

Auto. Dishwasher: ☑ Yes ☐ No


Auto. Washing Machine: ☐ Yes ☐ No

Other

☐ Slab ☐ Crawl Space ☐ Basement w/plumbing ☐ Basement w/o plumbing

Comments See detail sheets for Pump set up + Pressure manifold detail. use Pump that will deliver 40gal/min at 40' Total Head wire Pump + Alarm to meet State Elec. code standards

INITIAL SITE SKETCH

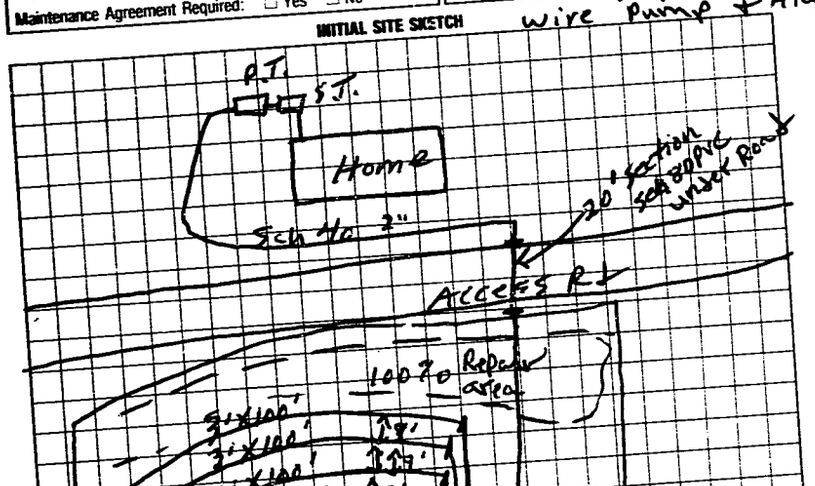

AS BUILT SKETCH

Same as initial sketch

I understand that this permit can be suspended or revoked if any false information is supplied toward securing the permit/any unauthorized changes are made to the site/any unauthorized changes are made in the installation of the system. Improvement Permit is valid for 60 months from date of issuance.

Signed: x Bell Hurt

Improvement Permit by: F.C. moore date 9-29-93

Existing System Inspection by: date

Installed by: Donald Lackey

Certificate of Completion by: F.C. moore date 10-20-93

Operation Permit by: date

HEALTH DEPT. COPY: WHITE INSPECTION COPY (FINAL): GREEN OWNER COPY (FINAL): YELLOW INSPECTION COPY (INITIAL): PINK OWNER COPY (INITIAL): GOLD

J.