THIS PERMIT REPLACES PERMIT ISSUED FOR 4BR ON 8-5-2005

IREDELL COUNTY HEALTH DEPARTMENT

STATESVILLE 704-878-5305 MOORESVILLE 704-664-5281

IMPROVEMENT PERMIT / AUTHORIZATION TO CONSTRUCT / OPERATION PERMIT / EXISTING SYSTEM INSPECTION

PERMIT# 129854 PIN# 4784-11-0276 / 4784911450 DATE 5-3-06

OWNER OR APPLICANT MIKE NEADER PHONE: Business 704-450-7703 Home 704-663-8291

ADDRESS 131 KEENAN LANE, MOORESVILLE, NC 28115

LOCATION US 70 EAST, TL ELMWOOD ROAD, 1ST DRIVE ON LEFT PAST MILLS GARDEN ROAD

SUBDIVISION _____ BLOCK / SECTION _____ LOT _____ LOT AREA 25 ACRES SITE CLASS. PS DESIGN FLOW 600 L.T.A.R. 0.40 GPD/FT²

Septic Tank: 1500 Gallons; STB S28 Date 5-29-07
Pump Tank: _____ Gallons; PT _____ Date _____
Pump Make: _____ Model _____ Serial No. _____
Nitrification Field: No Fields 1 Square Feet _____ Linear Feet _____
No Lines FIVE Trench Width 36" Trench Bottom Depth 38"+ Gravel Depth 12"

☑ New System ☐ Repair ☐ Expansion System Type: I (II) III IV V VI
System Description: SAND-LINED CONVENTIONAL
Repair System Description: DRIP IRRIGATION
Maintenance Agreement Required: ☐ Yes ☑ No

☐ House/Mod. Home ☐ Mobile Home ☐ Business ☐ Other
No. Bedrooms 5 No. Persons ____ No. Employees ____


Water Supply: ☐ Individual ☑ Public ☐ Community

☐ Slab ☐ Crawl Space ☑ Basement w/plumbing ☐ Basement wo/plumbing


Comments:/Conditions: EXCAVATE TRENCHES 38"+ DEEP. LINE TRENCH BOTTOM WITH 18" SCREENED SAND. INSTALL 12" GRAVEL ABOVE SAND WITH 4" CORRUGATED DRAIN PIPE.

Comments:/Conditions: Yellow Inspection Sheet

INITIAL SITE SKETCH ~ SCALE: 1"=50'

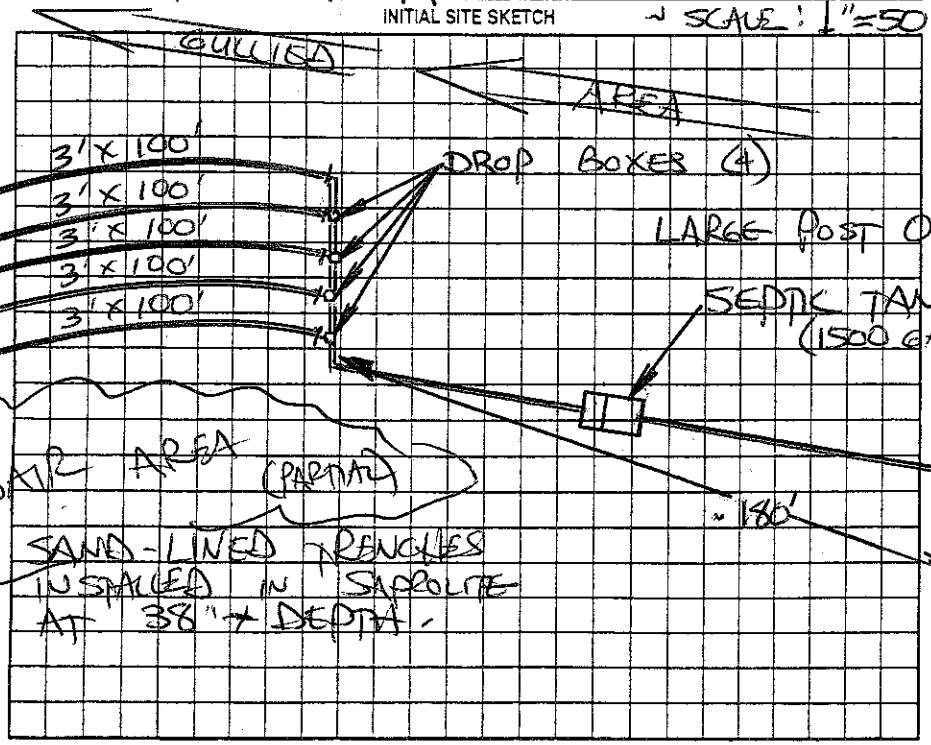

AS BUILT SKETCH

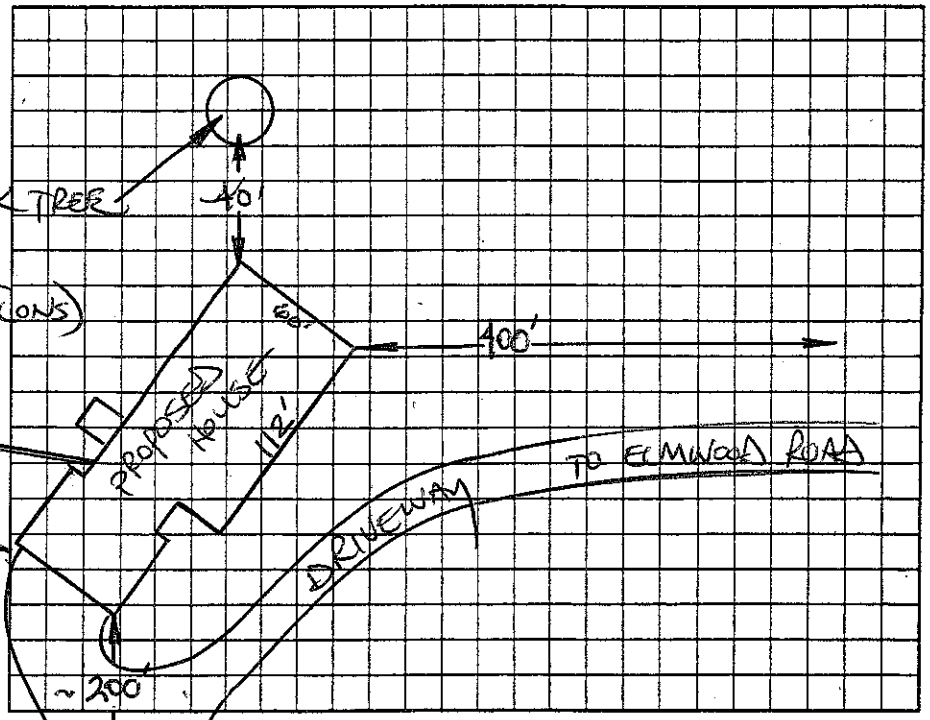

Permit can be suspended or revoked if any false information is supplied toward securing the permit/any unauthorized changes are made to the site/any unauthorized changes are made in the installation of the system. Improvement Permit with plat valid without expiration ☐ Improvement Permit with site plan valid for sixty months ☑ Authorization to Construct is valid for a period equal to that of Improvement Permit – not to exceed sixty months.

Signed: mike neader date 5-8-06 Installed by: DAVID YOUNTZ

Improvement Permit by: STEVE HEDRICK date 5-3-06 Operation Permit by: _____ date 10-17-07

Authorization to Construct by: STEVE HEDRICK date 5-3-06 Existing System Inspection by: _____ date _____

HEALTH DEPT. COPY: WHITE OWNER COPY (FINAL): YELLOW OWNER COPY (INITIAL): PINK

Re permit #16552 attached for accessory bldg. addition 3-7-2011.