IREDELL COUNTY HEALTH DEPARTMENT

STATESVILLE 704-878-5305 MOORESVILLE 704-664-5281

IMPROVEMENT PERMIT / AUTHORIZATION TO CONSTRUCT / OPERATION PERMIT / EXISTING SYSTEM INSPECTION

PERMIT# 75515 PIN# 4775 10 1869

OWNER OR CONTRACTOR Jan Petree DATE 8-17-98

ADDRESS 605 Greenberry Dr. Lynn. PHONE: Business Home 873 5367

LOCATION 64E TR New Salem TR Gayle Drive TL Verna ct on Rt

SUBDIVISION BLOCK / SECTION LOT 27 LOT AREA 1.72 acres SITE CLASS PS DESIGN FLOW 360 L.T.A.R. 1.27

Septic Tank: 1000 Gallons; STB 1012 Date 6-2-99
Pump Tank: Gallons; PT Date
Pump Make: Model Serial No.
Nitrification Field: No Fields 1 Square Feet 1350 Linear Feet 450
No Lines 3 Trench Width 36" Max Trench Bottom Depth 36" Gravel Depth

[X] New System [ ] Repair System Type: [ ] I [X] II, [ ] III, [ ] IV, [ ] V, [ ] VI
System Description: Conv. Gravity
Repair System Description: 2590 Rctu. System
Maintenance Agreement Required: [ ] Yes [X] No


[X] House/Mod. Home No. Bedrooms 3
[ ] Mobile Home No. Bathrooms 2
[ ] Business No. Employees
[ ] Other
[ ] Slab [X] Crawl Space [ ] Basement w/plumbing [ ] Basement wo/plumbing

Water Supply: [ ] Individual [X] Public [ ] Community


Comments:/Conditions:

Comments:/Conditions:

INITIAL SITE SKETCH

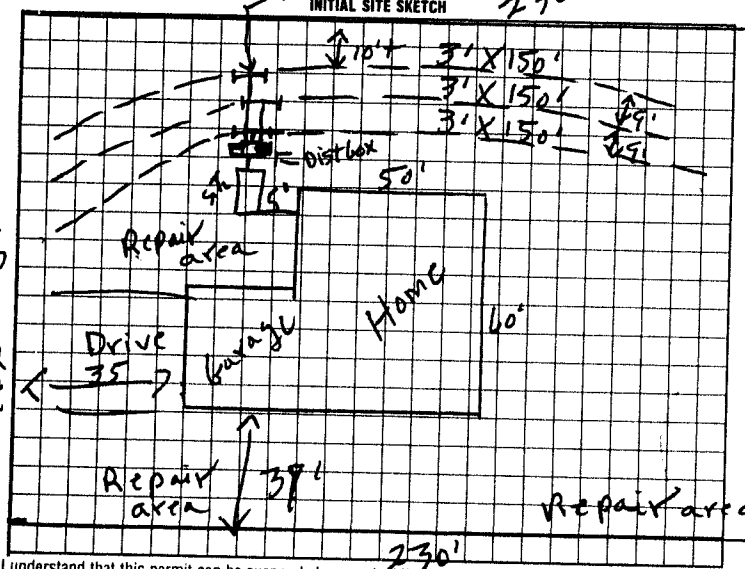

AS BUILT SKETCH

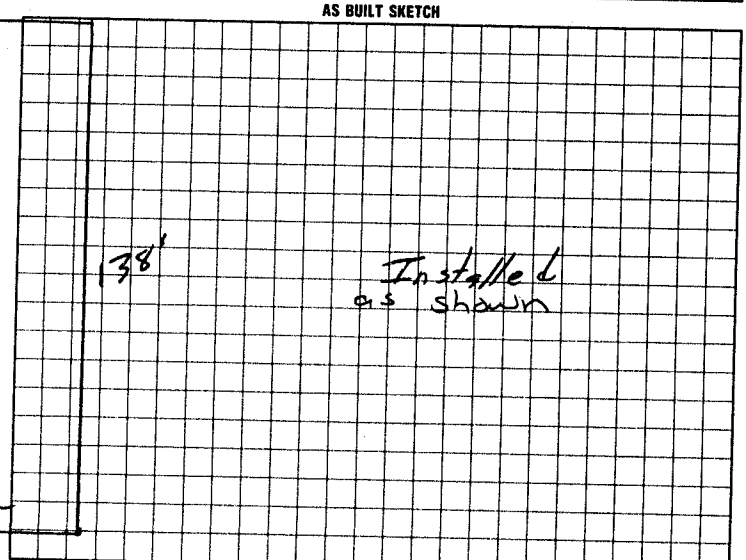

I understand that this permit can be suspended or revoked if any false information is supplied toward securing the permit/any unauthorized changes are made to the site/any unauthorized changes are made in the installation of the system. Improvement Permit with plat valid without expiration. Improvement Permit with site plan valid for sixty months. Authorization to Construct is valid for a period equal to that of Improvement Permit – not to exceed sixty months.

Signed: X Jan Petree date

Improvement Permit by: F. C. Moore date 8-17-98

Authorization to Construct by: F. C. Moore date 8-17-98

Installed by: Steve Jordan

Operation Permit by: Allen Coffey RS date 8-12-99

Existing System Inspection by: date

HEALTH DEPT. COPY: WHITE INSPECTION COPY (FINAL): GREEN OWNER COPY (FINAL): YELLOW INSPECTION COPY (INITIAL): PINK OWNER COPY (INITIAL): GOLD