IREDELL COUNTY HEALTH DEPARTMENT

STATESVILLE 704-878-5305 CI MOORESVILLE 704-664-5281

IMPROVEMENT PERMIT / AUTHORIZATION TO CONSTRUCT / OPERATION PERMIT / EXISTING SYSTEM INSPECTION

PERMIT# 108365 PIN# 4775-01-8098 DATE 09-04-02

OWNER OR CONTRACTOR TYRONE BROWN PHONE: Business — Home 704-881-0536

ADDRESS 819-B EAST FRONT STREET STATESVILLE NC 28677

LOCATION 64 EAST, (R) NEW SALEM RD, (R) LYNNGALE, (L) VERNA, LOT # 29 ON RT

SUBDIVISION CAMPBELL GLEN BLOCK / SECTION — LOT 29 LOT AREA .73 AC SITE CLASS PS DESIGN FLOW 480 L.T.A.R. .25

Septic Tank: 1000 Gallons; STB 825 Date 12-20-02
Pump Tank: — Gallons; PT — Date —
Pump Make: — Model — Serial No. —
Nitrification Field: No Fields 1 Square Feet 1920' Linear Feet EQ 480'
No Lines 6x80' Trench Width 36" Max Trench Bottom Depth 36" Gravel Depth NA

☒ New System ☐ Repair System Type: I, II, III, IV, V, VI
System Description: 6 GRAL 7500 1260
Repair System Description: LP PANEL
Maintenance Agreement Required: ☐ Yes ☒ No


☒ House/Mod. Home No. Bedrooms 4
☐ Mobile Home No. Bathrooms 2
☐ Business No. Employees —
☐ Other —

☐ Slab ☒ Crawl Space ☐ Basement w/plumbing ☐ Basement wo/plumbing


Water Supply: ☐ Individual ☒ Public ☐ Community

Comments/Conditions: (1) INSTALL DRAPULINES AT 36" DUE TO BETTER SOILS (2) MAINTAIN SETBACKS (3) CALL PRIOR TO INSTALLATION FOR CONSULTATIVE VISIT. (4) GRADE OUT SMALL TERRACE AT LOWER END OF LOT (5) USE FLOW DIVIDER TEES & 4 DROP BOXES (6) SYSTEM & HOUSE IS FLAGGED OUT DOLYLOK FILTER & MARKER. INSTALLED AS DRAWN

INITIAL SITE SKETCH 1" ≈ 50'

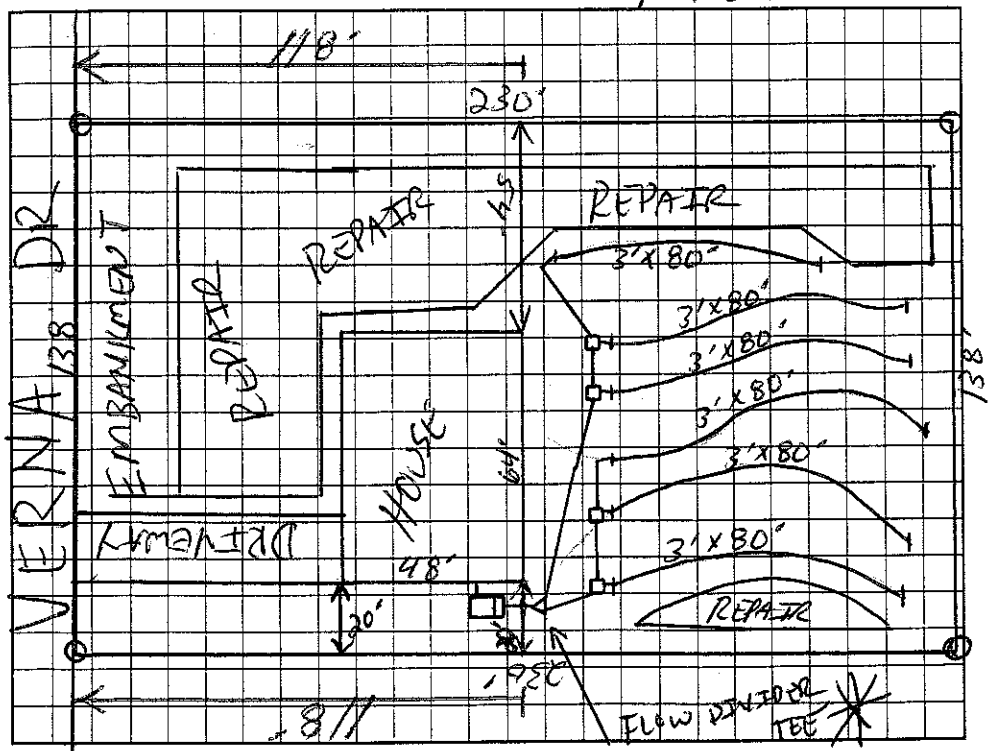

AS BUILT SKETCH

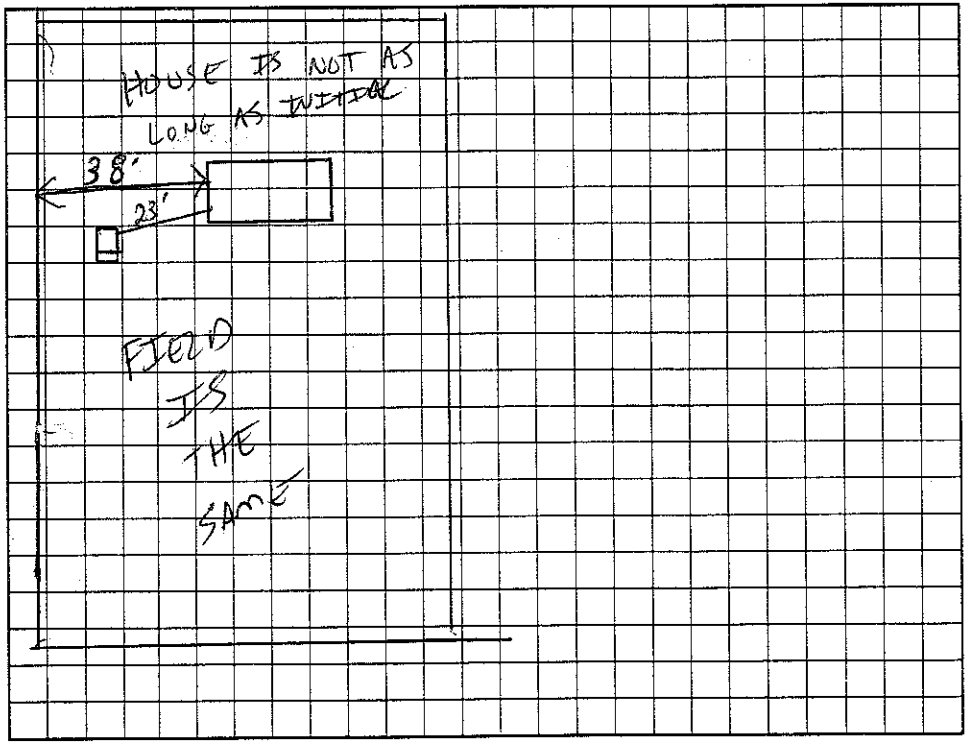

Permit can be suspended or revoked if any false information is supplied toward securing the permit/any unauthorized changes are made to the site/any unauthorized changes are made in the installation of the system. Improvement Permit with plat valid without expiration. Improvement Permit with site plan valid for sixty months. Authorization to Construct is valid for a period equal to that of Improvement Permit – not to exceed sixty months.

Signed: [signature] date 9/5/02 Installed by: ROWAN SEPTIC

Improvement Permit by: [signature] RS date 9-4-02 Operation Permit by: [signature] date 0206-03

Authorization to Construct by: [signature] RS date 9-4-02 Existing System Inspection by: — date —

HEALTH DEPT. COPY: WHITE OWNER COPY (FINAL): YELLOW OWNER COPY (INITIAL): PINK