IREDELL COUNTY HEALTH DEPARTMENT

STATESVILLE 704-878-5305 MOORESVILLE 704-664-5281

IMPROVEMENT PERMIT / AUTHORIZATION TO CONSTRUCT / OPERATION PERMIT / EXISTING SYSTEM INSPECTION

PERMIT# 79112 PIN# 4775018292 DATE 2-11-99

OWNER OR CONTRACTOR David Russ PHONE: Business Home 799 2382

ADDRESS 1095 Shinnville Cleveland N.C.

LOCATION Campbell 64E TR New Salem ch TR Campbell Glenn across Rt 64 Jct

SUBDIVISION Glenn BLOCK / SECTION LOT 30 LOT AREA .73 acres SITE CLASS P5 DESIGN FLOW 360 L.T.A.R. 1.3

Septic Tank: 1000 Gallons; STB 794 Date 9-20-99
Pump Tank: Gallons; PT Date
Pump Make: Model Serial No.
Nitrification Field: No. Fields 1 Square Feet 1200 Linear Feet 400
No Lines 5 Trench Width 36" Max Trench Bottom Depth 36" Gravel Depth 12"

☑ New System ☐ Repair System Type: ☐ I ☐ II ☐ III ☐ IV ☐ V ☐ VI
System Description: Conv. Gravity
Repair System Description:
Maintenance Agreement Required: ☐ Yes ☑ No


☑ House/Mod. Home No. Bedrooms 3
☐ Mobile Home No. Bathrooms 2
☐ Business No. Employees
☐ Other
☐ Slab ☑ Crawl Space ☐ Basement w/plumbing ☐ Basement wo/plumbing

Water Supply: ☐ Individual ☑ Public ☐ Community


Comments/Conditions:

Comments/Conditions:

INITIAL SITE SKETCH

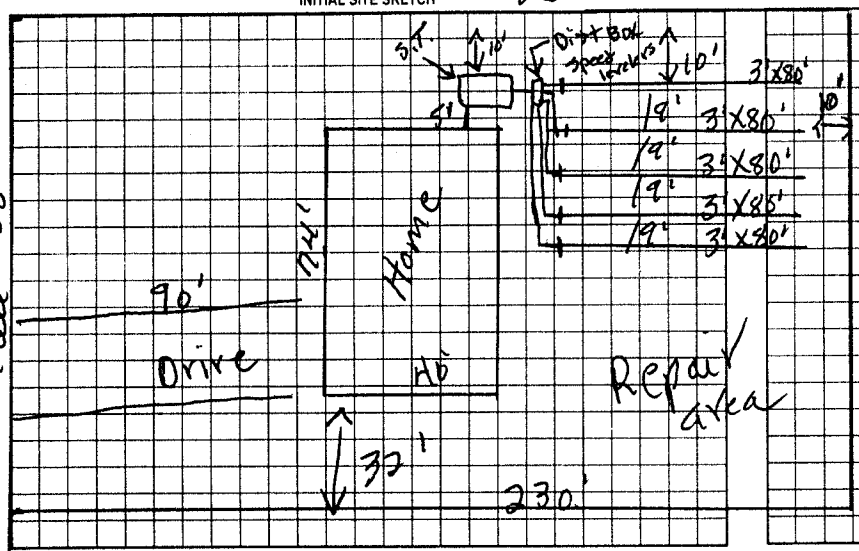

AS BUILT SKETCH

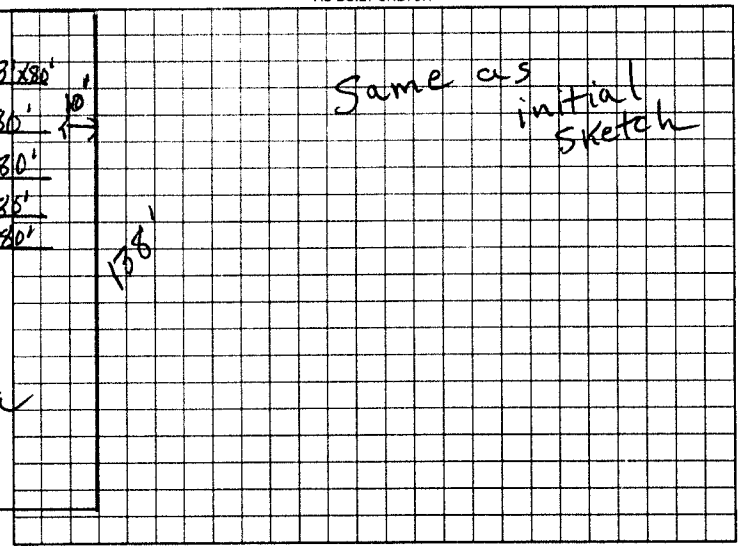

Permit can be suspended or revoked if any false information is supplied toward securing the permit/any unauthorized changes are made to the site/any unauthorized changes are made in the installation of the system. Improvement Permit with plat valid without expiration. Improvement Permit with site plan valid for sixty months. Authorization to Construct is valid for a period equal to that of Improvement Permit - not to exceed sixty months.

Signed: X David Russ date Installed by: James Hutler

Improvement Permit by: E.C. Moore date 2-11-99 Operation Permit by: E.C. Moore date 9-15-99

Authorization to Construct by: E.C. Moore date 2-11-99 Existing System Inspection by: date

HEALTH DEPT. COPY WHITE OWNER COPY (FINAL) YELLOW OWNER COPY (INITIAL) PINK