IREDELL COUNTY HEALTH DEPARTMENT

THIS PERMIT VOIDS PREVIOUS ISSUED 4-22-03

STATESVILLE 704-878-5305 (C) MOORESVILLE 704-664-5281

IMPROVEMENT PERMIT / AUTHORIZATION TO CONSTRUCT / OPERATION PERMIT / EXISTING SYSTEM INSPECTION

PERMIT# 090893 PIN# 4775-01-9735 0959 DATE 10-6-03

OWNER OR CONTRACTOR LLOYD & STEPHANIE BELL PHONE: Business 704-902-3777 Home 704-873-9132

ADDRESS 600 LONGVIEW ROAD, STATESVILLE NC 28625

LOCATION US 64 EAST, TR NEW SALEM RD, TR L/N GAYLE, TR VERNA DRIVE, AT END TO LEFT

SUBDIVISION CAMPBELL GLEN BLOCK / SECTION 2 LOT 34 LOT AREA 1.036 ACRES SITE CLASS. PS DESIGN FLOW 480 L.T.A.R. 0.25 GPD/FT²

Septic Tank: 1000 Gallons; STB 1012 Date 5-30-03
Pump Tank: ____ Gallons; PT ____ Date ____
Pump Make: ____ Model ____ Serial No. ____
Nitrification Field: No Fields 1 Square Feet FOOTPRINT 1920 Linear Feet 480
No Lines FIVE Trench Width 36" Max Trench Bottom Depth 24" Gravel Depth N/A

☑ New System ☐ Repair System Type: I, II, III, IV, V, VI
System Description: 25% REDUCTION, GRAVITY
Repair System Description: LOW PRESSURE PIPE
Maintenance Agreement Required: ☐ Yes ☑ No


☑ House/Mod. Home No. Bedrooms 4
☐ Mobile Home No. Bathrooms 2
☐ Business No. Employees ____
☐ Other ____
☐ Slab ☑ Crawl Space ☐ Basement w/plumbing ☐ Basement wo/plumbing

Water Supply: ☐ Individual ☑ Public ☐ Community

Comments:/Conditions: ① INSTALL 25% REDUCTION SYSTEM ON CONTOUR AS SHOWN ② INSTALL SUBSURFACE INTERCEPT DRAINAGE DITCH BEGINNING 48" DEEP

Comments:/Conditions: SEPTIC TANK WITH MARKER INSTALLED USING "TUFTITE" FILTER

INITIAL SITE SKETCH

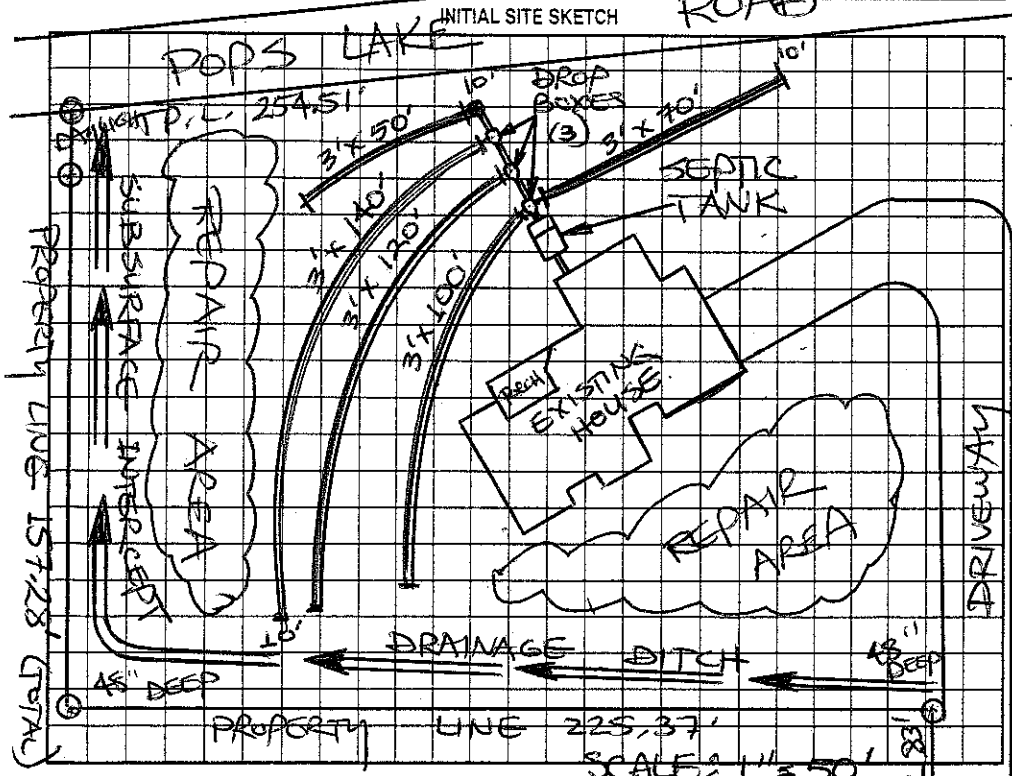

AS BUILT SKETCH

SYSTEM ACCORDING TO INITIAL SITE SKETCH

Permit can be suspended or revoked if any false information is supplied toward securing the permit/any unauthorized changes are made to the site/any unauthorized changes are made in the installation of the system. Improvement Permit with plat valid without expiration. Improvement Permit with site plan valid for sixty months. Authorization to Construct is valid for a period equal to that of Improvement Permit – not to exceed sixty months.

Signed: Stephanie J. Bell date 10-8-03 Installed by: A-1 BACKHOE

Improvement Permit by: STEVE HEDRICK date 10-6-03 Operation Permit by: STEVE HEDRICK date 12-1-03

Authorization to Construct by: STEVE HEDRICK date 10-6-03 Existing System Inspection by: ____ date ____

HEALTH DEPT. COPY: WHITE OWNER COPY (FINAL): YELLOW OWNER COPY (INITIAL): PINK

VERNA DRIVE CUL-DE-SAC