IREDELL COUNTY HEALTH DEPARTMENT

Statesville Office (704) 878-5305 | Mooresville Office (704) 660-3625 | PERMIT # 205153

IMPROVEMENT PERMIT / AUTHORIZATION TO CONSTRUCT / OPERATION PERMIT / EXISTING SYSTEM

PIN # 4775040268

APPLICANT: Beverly ~~Thomas~~ Gish | APPLICANT ADDRESS: 147 Morning Dove Ln Statesville NC 28625

SITE ADDRESS: 187 Winding Brookway Statesville NC | PHONE: 704-658-1723 | ALT. PHONE: 704-252-0784

SITE DIRECTIONS: 64 W T/R Sain Rd T/L Winding Brook Way Lot on left in curve

SUBDIVISION: Spring Forest | SECTION: N/A | LOT # 21 | LOT AREA: 1.564ac | DESIGN FLOW: 480 | L.T.A.R.: 0.3

Septic Tank	1000 (gal)	STB	1012	Date	5-20-14	[X] New System [ ] Repair [ ] Expansion	System Type: I II [III] IV V VI	[X] Residence	No. Bedrooms 4
Pump Tank	N/A (gal)	PT	N/A	Date	N/A	System Description:	25% Reduction	[ ] Business	No. Persons 8
Pump Make	N/A	Model	Tuftite	Serial #	EF4	Repair System Description:	Pump 25% Reduction	[ ] Other	No. Employees
# Nitrification Fields	1	# Lines	6	Linear Ft:	400	Maintenance Agreement Required:	[ ] YES [X] NO	[ ] Slab	[X] Crawl Space
Trench Width	36"	Max. Trench Bottom Depth	30"	Gravel Depth	N/A		[X] GRAVITY [ ] PRESSURE	[ ] Basement w/plumbing	[ ] Basement w/o plumbing

Water Supply: [ ] Private [X] Public [ ] Community

Comments / Conditions: Install 25% Reduction on Contour with serial distribution

INITIAL SITE SKETCH

See Site plan by Rollans Soil + Environmental Services

Install per site plan

AS BUILT SKETCH

Installed Quick4

As drawn

Permit can be suspended or revoked if any false information is supplied toward securing the permit / any unauthorized changes are made to the site / any unauthorized changes are made in the installation of the system. **CONTACT A LOCATOR SERVICE PRIOR TO ANY EXCAVATION**

[ ] **IMPROVEMENT PERMIT** *with plat valid without expiration.* [X] **IMPROVEMENT PERMIT** *with site plan valid for 60 mos.* [X] **AUTHORIZATION TO CONSTRUCT** *valid for period equal to IMPROVEMENT PERMIT--not to exceed 60 mo.*

Owner / Applicant Signature: Beverly Gish Date:

IMPROVEMENT PERMIT by: Date: 08/27/14

AUTHORIZATION TO CONSTRUCT by: Date: 12/15/14


Installed by: Steve Jordan

OPERATION PERMIT by: Date: 08/14/15

Existing System Inspected by: Date:

Health Dept. Copy - WHITE Applicant (Final Approval) - YELLOW Applicant (Conditional Approval) - PINK

Curve	Radius	Tangent	Length	Chord	Chord Bear.
C1	350.00'	61.43'	121.62'	121.01'	S 38°40'57" E

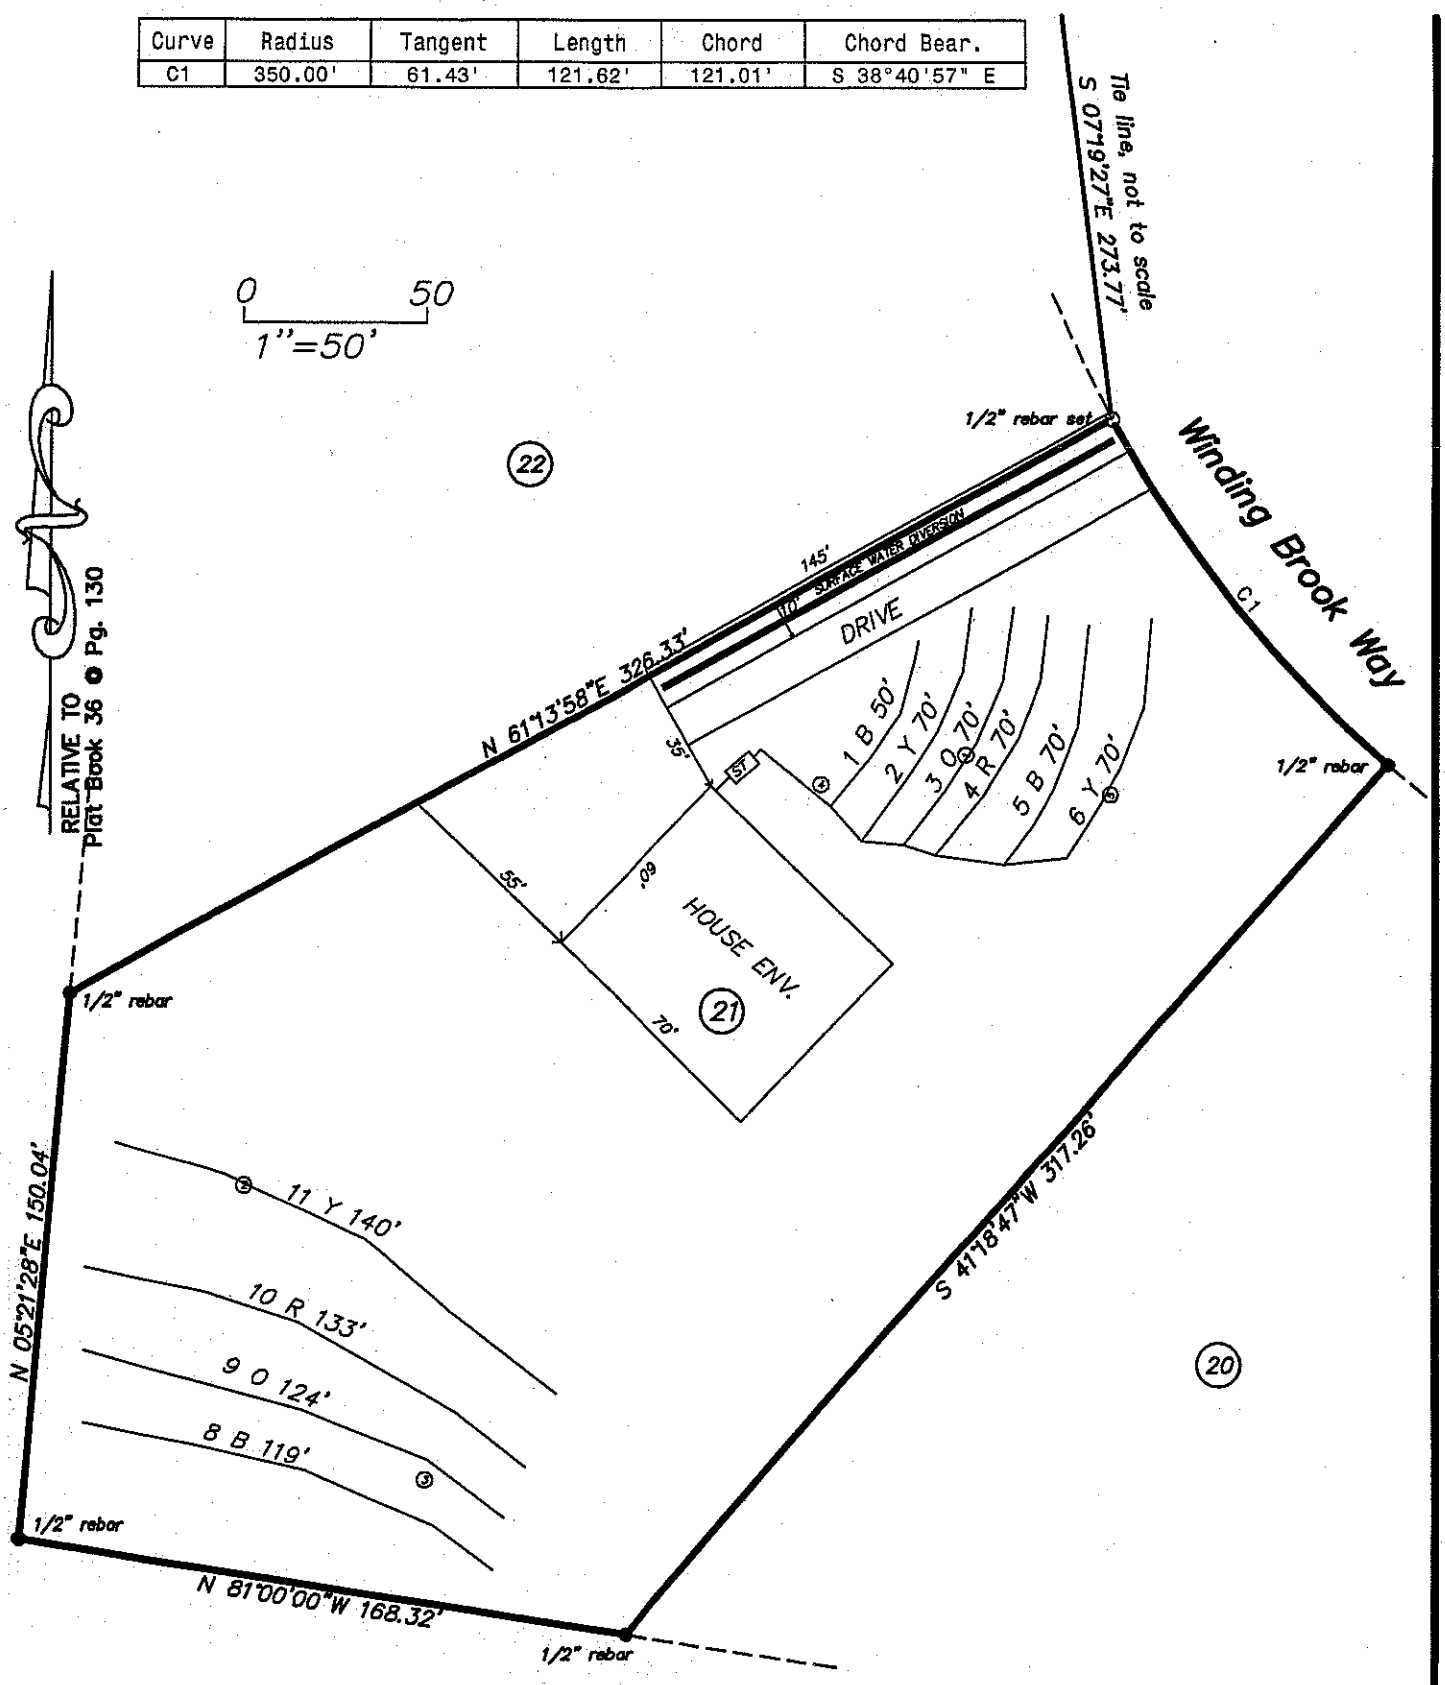

PRELIMINARY PLAT:
NOT FOR RECORDATION,
CONVEYANCES, OR SALES

TED BENBOW
Land Surveying

Work Map

Manuel Daskalos