IREDELL COUNTY HEALTH DEPARTMENT

STATESVILLE 704-878-5305 MOORESVILLE 704-664-5281

IMPROVEMENT PERMIT / AUTHORIZATION TO CONSTRUCT / OPERATION PERMIT / EXISTING SYSTEM INSPECTION

PERMIT# 13911 PIN# 4775040434 DATE 9-7-06

OWNER OR APPLICANT Buildrite Const PHONE: Business 704 2019935 Home

ADDRESS 245 Sweetbriar Rd Statesville NC 28625

LOCATION 64E TL Starr TL winding Brook

SUBDIVISION Springcrest BLOCK / SECTION LOT 22 LOT AREA SITE CLASS. 05 DESIGN FLOW 480 L.T.A.R. 125

Septic Tank: 1000 Gallons; STB 794 Date 12-5-06

Pump Tank: Gallons; PT Date

Pump Make: Model Serial No.

Nitrification Field: No Fields Square Feet 1920 Linear Feet 480

No Lines 4 Trench Width 36" Max Trench Bottom Depth 36" Gravel Depth NA

☐ New System ☐ Repair ☐ Expansion System Type: I II III IV V VI

System Description: 25% Expand

Repair System Description: Low Pressure

Maintenance Agreement Required: ☐ Yes ☐ No

☑ House/Mod. Home ☐ Mobile Home ☐ Business ☐ Other

No. Bedrooms 4 No. Persons No. Employees


Water Supply: ☐ Individual ☑ Public ☐ Community

☐ Gravity ☐ Pressure ☐ Slab ☑ Crawl Space ☐ Basement w/plumbing ☐ Basement wo/plumbing

Comments:/Conditions:

327

INITIAL SITE SKETCH

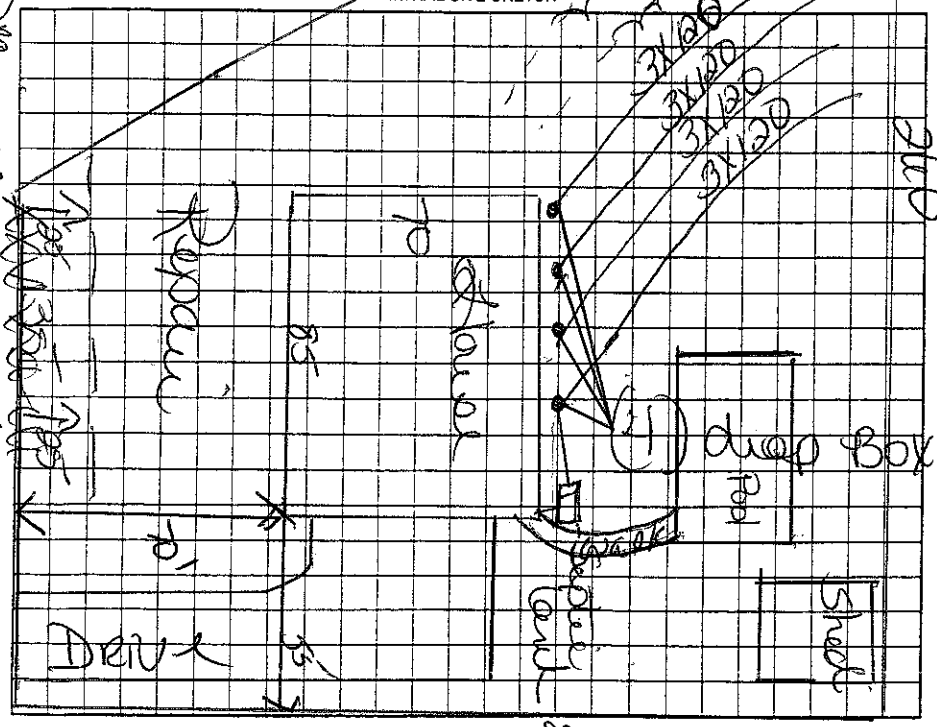

Comments:/Conditions:

Adjustable on Custom
Maintain all setbacks

AS BUILT SKETCH

Permit can be suspended or revoked if any false information is supplied toward securing the permit/any unauthorized changes are made to the site/any unauthorized changes are made in the installation of the system. Improvement Permit with plat valid without expiration ☐ Improvement Permit with site plan valid for sixty months ☐ Authorization to Construct is valid for a period equal to that of Improvement Permit – not to exceed sixty months.

Signed: Joe Hyde date 9-17-06 Installed by: Madison Grading

Improvement Permit by: Kelly Cook date 9-17-06 Operation Permit by: James Orr date 1-17-06

Authorization to Construct by: Kelly Cook date 9-17-06 Existing System Inspection by: date

HEALTH DEPT. COPY: WHITE OWNER COPY (FINAL): YELLOW OWNER COPY (INITIAL): PINK