IREDELL COUNTY HEALTH DEPARTMENT

STATESVILLE 704-878-5305 (S) MOORESVILLE 704-664-5281

IMPROVEMENT PERMIT / AUTHORIZATION TO CONSTRUCT / OPERATION PERMIT / EXISTING SYSTEM INSPECTION

PERMIT# 114085 PIN# 4775-04-0623 DATE 7-30-03

OWNER OR CONTRACTOR TODD ELLIS PHONE: Business 704-902-0113 Home

ADDRESS 315 SPRING SPRINGS LOOP STATESVILLE, NC 28625

LOCATION 64 EAST (L) SALEM, (L) WINDRUSH BROOKE, LOT # 23 ATTN ON LEFT BY (S) - DE-SAC

SUBDIVISION SPRING FOREST BLOCK / SECTION LOT 23 LOT AREA .2127 SITE CLASS. PS DESIGN FLOW 360 L.T.A.R. .3

Septic Tank: 1000 Gallons: STB 1012 Date 6-11-03
Pump Tank: Gallons: PT Date
Pump Make: Model Serial No.
Filtration Field: No Feets Square Feet EQ 1200' Linear Feet 300'
No Lines 5X60' Trench Width 36" Max Trench Bottom Depth 36" Gravel Depth N/A

(X) New System ☐ Repair System Type: I, II, (III), IV, V
System Description: 6 RAY 25% E BOX TREW
Repair System Description: LP PANEL
Maintenance Agreement Required: ☐ Yes (X) No

(X) House/Mod. Home No. Bedrooms 3
☐ Mobile Home No. Bathrooms 3
☐ Business No. Employees
☐ Other

Water Supply: ☐ Individual (X) Public ☐ Community


☐ Slab ☐ Crawl Space ☐ Basement w/plumbing ☐ Basement w/o plumbing

Comments/Conditions: (1) INSTALL LINES ON CONTOURS (2) MEET SETBACKS (3) SYSTEM IS DESIGNED FOR A 3 BEDROOM HOUSE.

Comments/Conditions: SEPTIC TANK WITH MARKED RISERS TO SURFACE "SUPRATEC" FILTER

INITIAL SITE SKETCH

1" = 50'

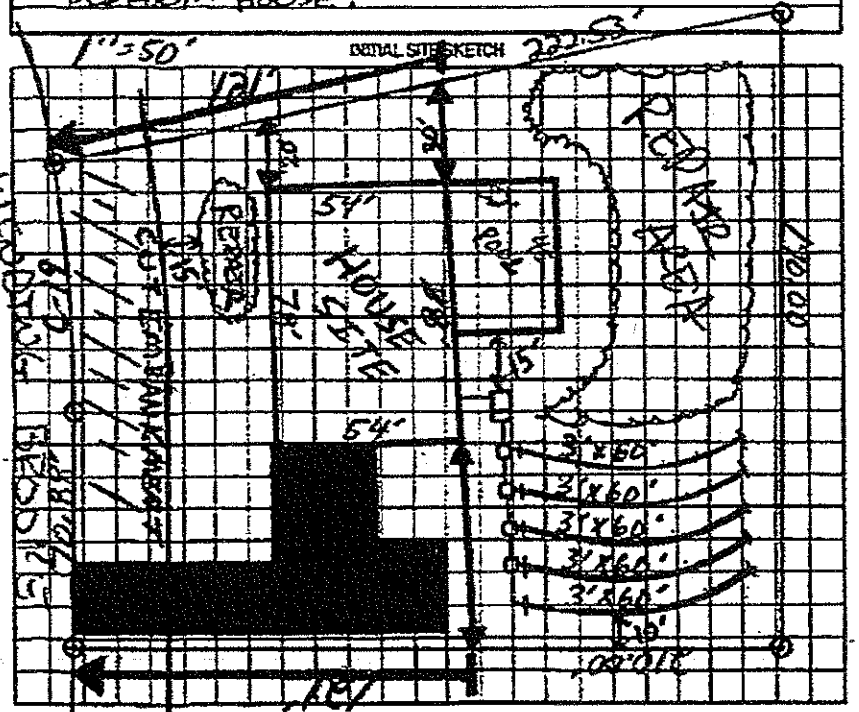

AS BUILT SKETCH

SYSTEM INSTALLED ACCORDING TO INITIAL SITE SKETCH

Permit can be suspended or revoked if any false information is supplied toward securing the permit/any unauthorized changes are made to the site/any unauthorized changes are made in the installation of the system. Improvement Permit with plat valid without expiration. Improvement Permit with site plan valid for sixty months. Authorization to Construct is valid for a period equal to that of Improvement Permit – not to exceed sixty months.

Signed: [signature] date 7-31-03

Improvement Permit by: [signature] RS date 7-30-03

Authorization to Construct by: [signature] RS date 7-30-03

Installed by: DAVID YOUNTZ

Operation Permit by: STEVE HENDRICK date 12-8-03

Existing System Inspection by: date

HEALTH DEPT. COPY: WHITE OWNER COPY (FINAL): YELLOW OWNER COPY (INITIAL): PINK

match existing rear porch 18'1/2 X 9
Covered back 14 X 18'1/2