IREDELL COUNTY HEALTH DEPARTMENT

STATESVILLE 704-878-5305 (S) MOORESVILLE 704-664-5281

IMPROVEMENT PERMIT / AUTHORIZATION TO CONSTRUCT / OPERATION PERMIT / EXISTING SYSTEM INSPECTION

PERMIT# 114085 PIN# 4775-04-0623 DATE 7-30-03

OWNER OR CONTRACTOR TODD ELLIS PHONE: Business 704-902-0119 Home

ADDRESS 315 SEVIN SPRINGS LOOP STATESVILLE, NC 28625

LOCATION 64 EAST (L) SAIN, (L) WINDING BROOKE, LOT # 23 AT END ON LEFT RH CUL-DE-SAC

SUBDIVISION SPRING FORREST BLOCK / SECTION LOT 23 LOT AREA .8127 SITE CLASS. PS DESIGN FLOW 360 L.T.A.R. .3

Septic Tank: 1000 Gallons; STB 1012 Date 6-11-03
Pump Tank: Gallons; PT Date
Pump Make: Model Serial No.
Nitrification Field: No Fields Square Feet EQ#1200' Linear Feet 300'
No Lines 5x60' Trench Width 36" Max Trench Bottom Depth 36" Gravel Depth N/A

[X] New System [ ] Repair System Type: I, II, [III], IV, V, VI
System Description: GRAY 25% REDUCTION
Repair System Description: LP PANEL
Maintenance Agreement Required: [ ] Yes [X] No


[X] House/Mod. Home No. Bedrooms 3
[ ] Mobile Home No. Bathrooms 3
[ ] Business No. Employees
[ ] Other
[ ] Slab [X] Crawl Space [ ] Basement w/plumbing [ ] Basement wo/plumbing

Water Supply: [ ] Individual [X] Public [ ] Community

Comments:/Conditions: (1) INSTALL LINES ON CONTOURS (2). MAINTAIN SETBACKS (3) SYSTEM IS DESIGNED FOR A 3 BEDROOM HOUSE.

Comments:/Conditions: SEPTIC TANK WITH MARKER INSTALLED USING "INFILTE" FILTER

INITIAL SITE SKETCH

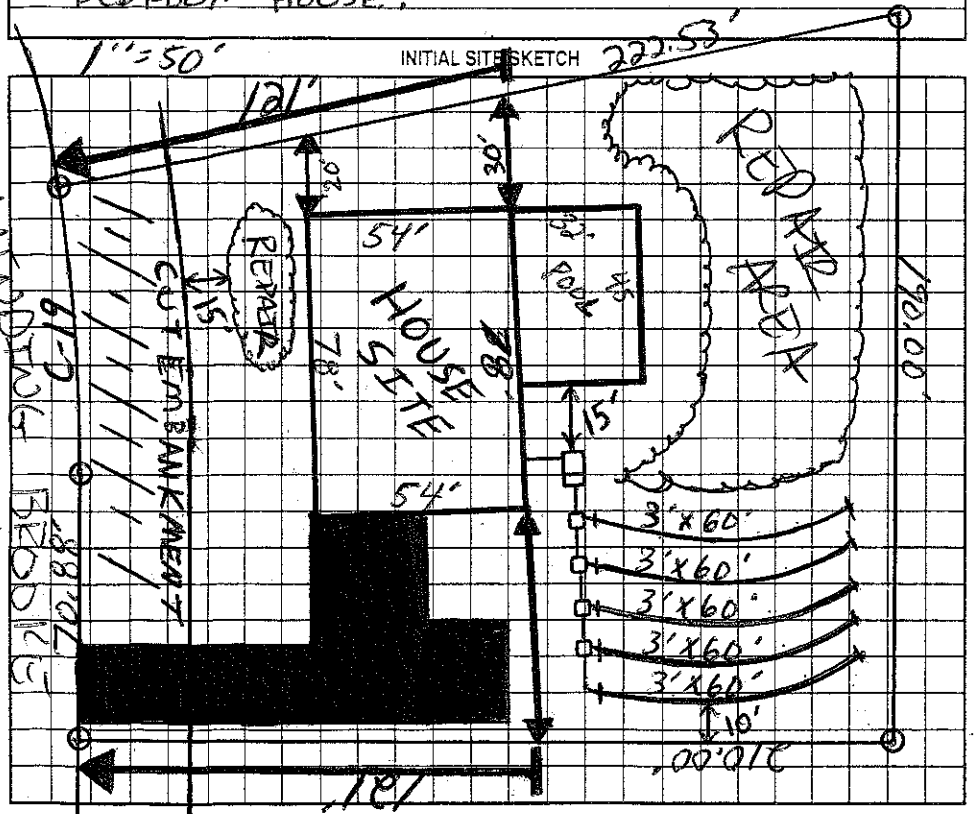

AS BUILT SKETCH

SYSTEM INSTALLED ACCORDING TO INITAL SITE SKETCH

Permit can be suspended or revoked if any false information is supplied toward securing the permit/any unauthorized changes are made to the site/any unauthorized changes are made in the installation of the system. Improvement Permit with plat valid without expiration. Improvement Permit with site plan valid for sixty months. Authorization to Construct is valid for a period equal to that of Improvement Permit – not to exceed sixty months.

Signed: date 7-31-03 Installed by: DAVID YOUNTZ

Improvement Permit by: date 7-30-03 Operation Permit by: STEVE HENDRICK date 12-8-03

Authorization to Construct by: date 7-30-03 Existing System Inspection by: date

HEALTH DEPT. COPY: WHITE OWNER COPY (FINAL): YELLOW OWNER COPY (INITIAL): PINK