IREDELL COUNTY HEALTH DEPARTMENT

Statesville Office (704) 878-5305 Mooresville Office (704) 660-3625 PERMIT # 210831

IMPROVEMENT PERMIT / AUTHORIZATION TO CONSTRUCT / OPERATION PERMIT / EXISTING SYSTEM

PIN # 4775040623

APPLICANT: Todd Ellis Builders APPLICANT ADDRESS: 271 Cooper Farm Rd.

SITE ADDRESS: 199 Winding Brookway PHONE: 704-873-7373 ALT. PHONE: N/A

SITE DIRECTIONS: Hwy 64E TL San Rd TL Winding Brook Way

SUBDIVISION: Spring Forest SECTION: N/A LOT # 23 LOT AREA: 0.81 acres DESIGN FLOW: 360gpd L.T.A.R.: Existing


Septic Tank	Existing (gal)	STB	Date	☐ New System ☐ Repair ☐ Expansion	System Type: I (II) III IV V VI	☑ Residence	No. Bedrooms	3	Water Supply
Pump Tank	(gal)	PT	Date	System Description:	Existing	☐ Business	No. Persons	6	☐ Private
Pump Make	Model		Serial #	Repair System Description:		☐ Other	No. Employees		☑ Public
# Nitrification Fields	Ex # Lines Ex		Linear Ft: Ex	Maintenance Agreement Required:	☐ YES ☑ NO	☐ Slab	☑ Crawl Space		☐ Community
Trench Width	Ex Max. Trench Bottom Depth Ex		Gravel Depth Ex	☑ GRAVITY	☐ PRESSURE	☐ Basement w/plumbing			☐ Basement w/o plumbing

Comments / Conditions:

- Maintain a minimum of 5' between addition foundation & all components of septic tank system

INITIAL SITE SKETCH

AS BUILT SKETCH

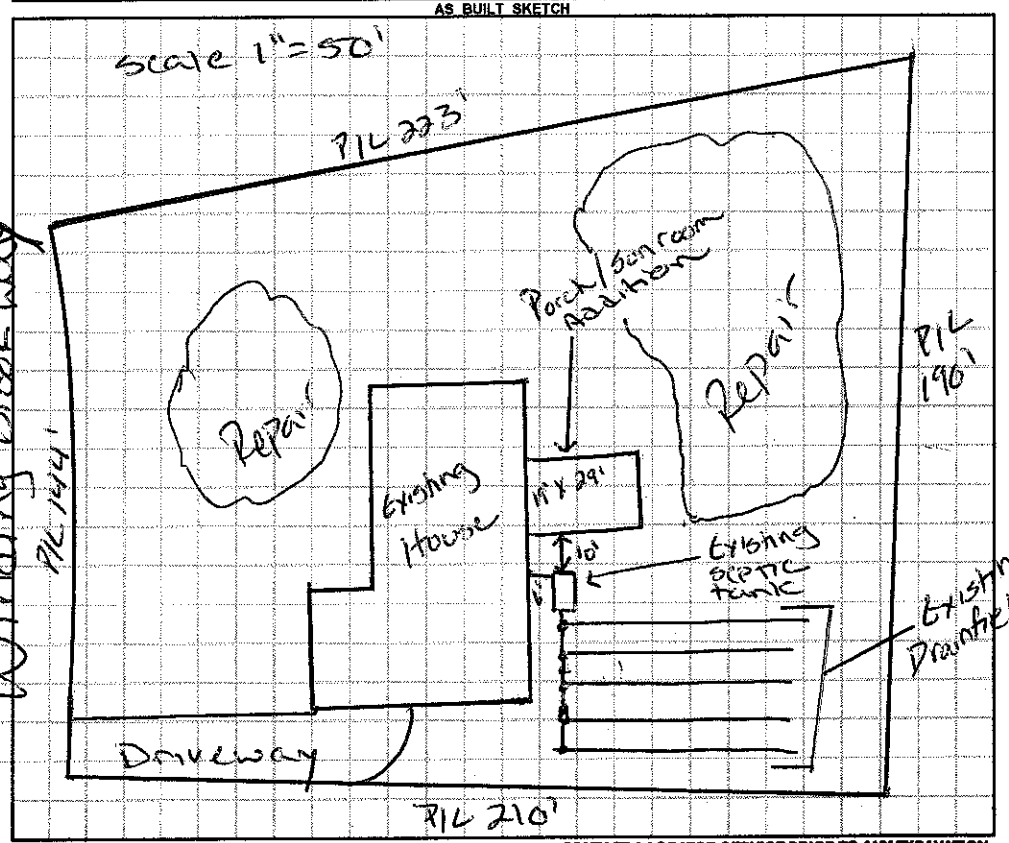

Permit can be suspended or revoked if any false information is supplied toward securing the permit / any unauthorized changes are made to the site / any unauthorized changes are made in the installation of the system. **CONTACT A LOCATOR SERVICE PRIOR TO ANY EXCAVATION**

☐ **IMPROVEMENT PERMIT** *with plat valid without expiration.* ☐ **IMPROVEMENT PERMIT** *with site plan valid for 60 mos.* ☐ **AUTHORIZATION TO CONSTRUCT** *valid for period equal to IMPROVEMENT PERMIT--not to exceed 60 mo.*

Owner / Applicant Signature: Date: Installed by:

IMPROVEMENT PERMIT by: Date: OPERATION PERMIT by: Date:

AUTHORIZATION TO CONSTRUCT by: Date: Existing System Inspected by: Justin Henderson Date:

Health Dept. Copy - WHITE Applicant (Final Approval) - YELLOW Applicant (Conditional Approval) - PINK