IREDELL COUNTY HEALTH DEPARTMENT

THIS PERMIT REPLACES PREVIOUS ISSUED 7-24-03

STATESVILLE 704-878-5305 (1) MOORESVILLE 704-664-5281

IMPROVEMENT PERMIT / AUTHORIZATION TO CONSTRUCT / OPERATION PERMIT / EXISTING SYSTEM INSPECTION

PERMIT# 113924 PIN# 4775-04-2243 DATE 1-13-04

OWNER OR CONTRACTOR DAVID LUTAR PHONE: Business 336-658-2486 Home 704-883-8805

ADDRESS 1929 CUNNINGHAM DRIVE, STATESVILLE, NC 28625

LOCATION US 64 EAST, TL SAIN ROAD, TL WINDING BROOK WAY, LOT ACROSS FROM POND ON LEFT

SUBDIVISION SPRING FOREST BLOCK / SECTION ____ LOT 20 LOT AREA 1.0061 ACRES SITE CLASS. PS DESIGN FLOW 480 L.T.A.R. 0.30 GPD/FT²

Septic Tank: 1000 Gallons; STB 1012 Date 8-4-03

Pump Tank: ____ Gallons; PT ____ Date ____

Pump Make: ____ Model ____ Serial No. ____

Nitrification Field: No Fields 1 Square Feet EQ TO 1600 Linear Feet 400

No Lines FIVE Trench Width 36" Max Trench Bottom Depth 36" Gravel Depth N/A

☑ New System ☐ Repair System Type: I, II, (III), IV, V, VI

System Description: 25% REDUCTION, GRAVITY

Repair System Description: 25% REDUCTION, GRAVITY

Maintenance Agreement Required: ☐ Yes ☑ No pump

☑ House/Mod. Home No. Bedrooms 4

☐ Mobile Home No. Bathrooms 2.5

☐ Business No. Employees ____

☐ Other ____


☐ Slab ☑ Crawl Space ☐ Basement w/plumbing ☐ Basement wo/plumbing

Water Supply: ☐ Individual ☑ Public ☐ Community

Comments:/Conditions: ① INSTALL 25% REDUCTION SYSTEM ON CONTOUR AS FLAGGED ② DO NOT INSTALL SYSTEM DURING WET SOIL CONDITIONS.

Comments:/Conditions: SEPTIC TANK WITH MARKER INSTALLED USING "TUFTITE" FILTER

INITIAL SITE SKETCH

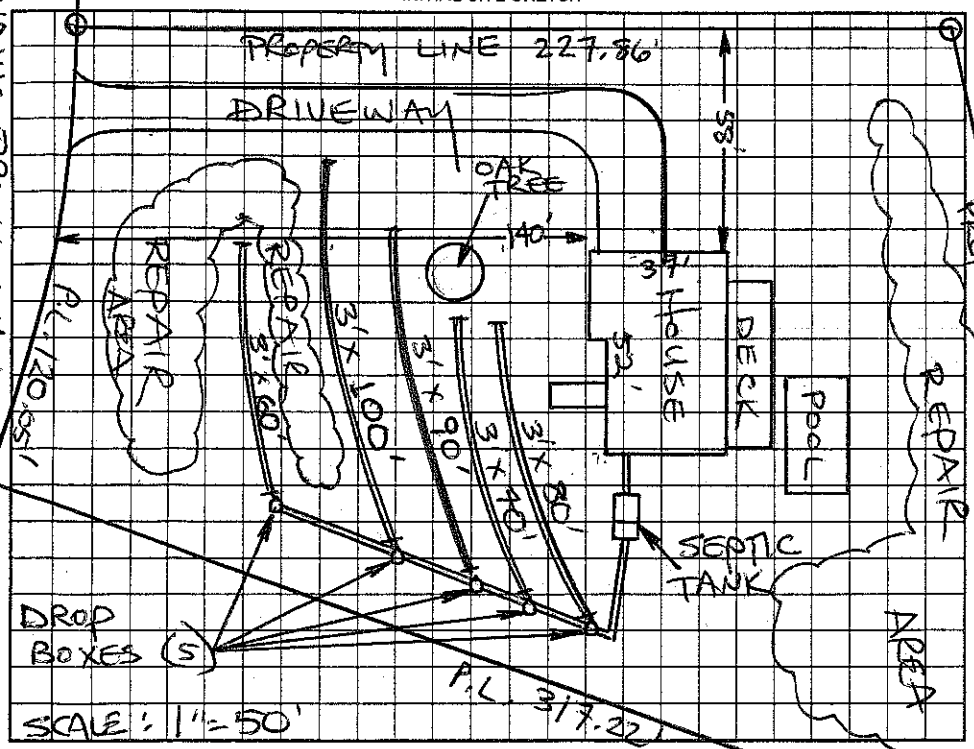

AS BUILT SKETCH

SYSTEM INSTALLED ACCORDING TO INITIAL SITE SKETCH

Permit can be suspended or revoked if any false information is supplied toward securing the permit/any unauthorized changes are made to the site/any unauthorized changes are made in the installation of the system. Improvement Permit with plat valid without expiration. Improvement Permit with site plan valid for sixty months. Authorization to Construct is valid for a period equal to that of Improvement Permit – not to exceed sixty months.

Signed: Tony L Lutar date 1-14-04 Installed by: A-1 BACKHOE

Improvement Permit by: STEVE HEDRICK date 1-13-04 Operation Permit by: STEVE HEDRICK date 1-16-04

Authorization to Construct by: STEVE HEDRICK date 1-13-04 Existing System Inspection by: ____ date ____

HEALTH DEPT. COPY: WHITE OWNER COPY (FINAL): YELLOW OWNER COPY (INITIAL): PINK