THIS PERMIT VOIDS PREVIOUS ISSUED 8.29-2001

IREDELL COUNTY HEALTH DEPARTMENT

STATESVILLE 704-878-5305 (C) MOORESVILLE 704-664-5281

IMPROVEMENT PERMIT / AUTHORIZATION TO CONSTRUCT / OPERATION PERMIT / EXISTING SYSTEM INSPECTION

PERMIT# 123910 PIN# ~~4775-04-3717~~ 4775-04-3898 DATE 9-22-04

OWNER OR CONTRACTOR JOSEPH COONEY PHONE: Business 704-902-0799 Home 704-872-3625

ADDRESS 1409 BROOKGREEN AVE, STATESVILLE, NC 28677

LOCATION US 64 EAST, TL SAW ROAD, TL WINDING BROOK WAY, AT END ON RIGHT

SUBDIVISION SPRING FOREST BLOCK / SECTION ____ LOT 27 & 28 LOT AREA 2.26 ACRES SITE CLASS. PS DESIGN FLOW 480 L.T.A.R. 0.35 GPD/FT²

Septic Tank: 1000 Gallons; STB 1017 Date 10-22-04 ☑ New System ☐ Repair System Type: I, II, (III), IV, V, VI ☑ House/Mod. Home No. Bedrooms 4

Pump Tank: 1000 Gallons; PT 17 Date 2-4-05 System Description: 25% REDUCTION, pump ☐ Mobile Home No. Bathrooms ____

Pump Make: GOULDS Model WE0312MH Serial No A054498 Repair System Description: 50% REDUCTION, pump ☐ Business No. Employees ____

Nitrification Field: No. Fields 1 Square Feet 1380 Linear Feet 345 Maintenance Agreement Required: ☐ Yes ☑ No ☐ Other ____


No Lines FOUR Trench Width 36" Max Trench Bottom Depth 36" Gravel Depth N/A ☐ Slab ☐ Crawl Space ☑ Basement w/plumbing ☐ Basement wo/plumbing

Water Supply: ☐ Individual ☑ Public ☐ Community


Comments:/Conditions: (1) INSTALL 25% REDUCTION SYSTEM ON CONTOUR AS FLAGGED (2) SEE ATTACHED SHEETS FOR PUMP & PRESSURE MANIFOLD REQUIREMENTS

Comments:/Conditions: SEPTIC TANK WITH MARKER INSTALLED USING "PUFFITE" FILTER

INITIAL SITE SKETCH

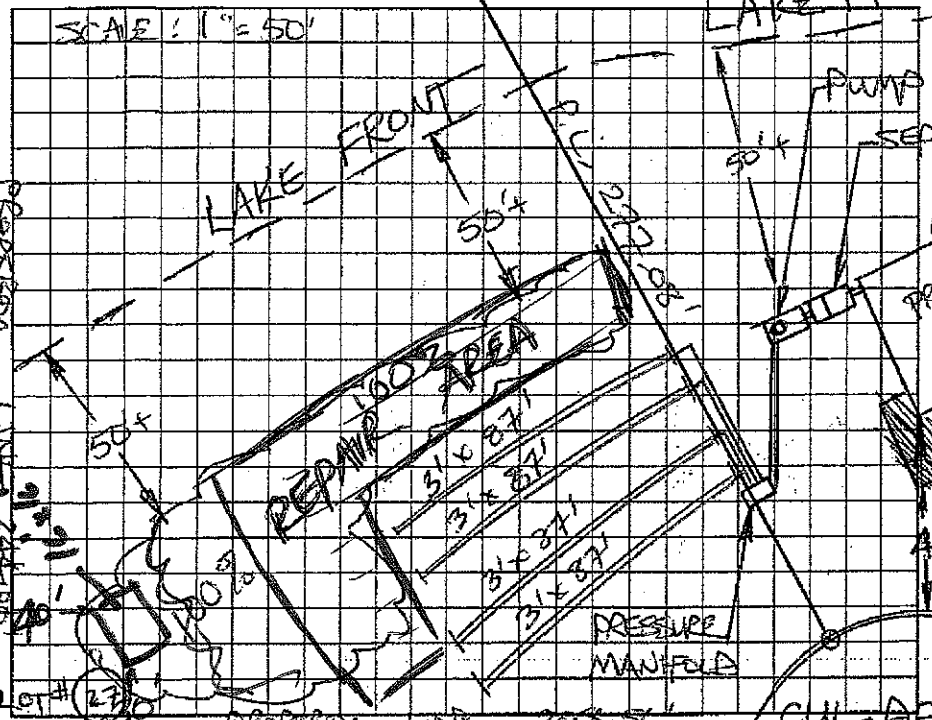

AS BUILT SKETCH

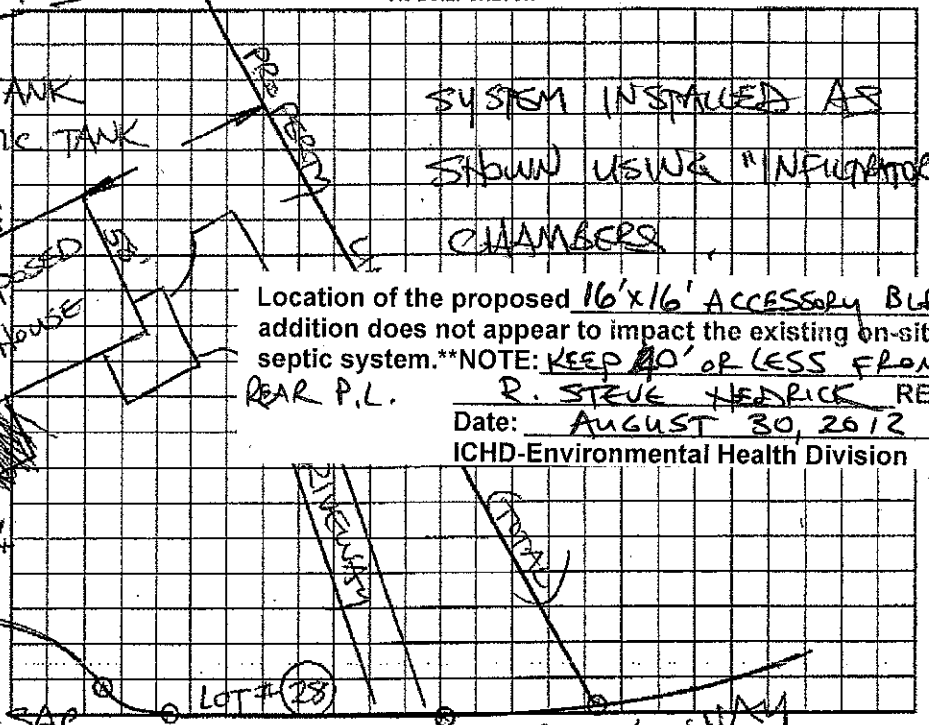

Location of the proposed 16'x16' ACCESSORY BLDG addition does not appear to impact the existing on-site septic system.**NOTE: KEEP 40' OR LESS FROM REAR P.L.

R. STEVE HEDRICK REHS

Date: AUGUST 30, 2012

ICHD-Environmental Health Division

Permit can be suspended or revoked if any false information is supplied toward securing the permit/any unauthorized changes are made to the site/any unauthorized changes are made in the installation of the system. Improvement Permit with plat valid without expiration. Improvement Permit with site plan valid for sixty months. Authorization to Construct is valid for a period equal to that of Improvement Permit – not to exceed sixty months.

Signed: _____ date 9/22/04 Installed by: DANA YOUNG

Improvement Permit by: STEVE HEDRICK date 9-22-04 Operation Permit by: STEVE HEDRICK date 6-29-05

Authorization to Construct by: STEVE HEDRICK date 9-22-04 Existing System Inspection by: _____ date _____

HEALTH DEPT. COPY: WHITE OWNER COPY (FINAL): YELLOW OWNER COPY (INITIAL): PINK