IREDELL COUNTY HEALTH DEPARTMENT

AP THIS PERMIT VOIDS #105758 ISSUED 5-8-02

STATESVILLE 704-878-5305 MOORESVILLE 704-664-5281

IMPROVEMENT PERMIT / AUTHORIZATION TO CONSTRUCT / OPERATION PERMIT / EXISTING SYSTEM INSPECTION

PERMIT# 125152 PIN# 4775-04-5891 DATE 12-16-04

OWNER OR CONTRACTOR NANCY SHEETS PHONE: Business Home 704-873-2156

ADDRESS 2649 FINES CREEK DRIVE STATESVILLE NC 28625

LOCATION US 64 EAST, TL SAIN RD, TL SPRING FOREST DR, TL 2ND HOWARD POND LOOP, 4TH LOT ON RIGHT

SUBDIVISION SPRING FOREST BLOCK / SECTION LOT 53 LOT AREA 1.5123 ACRES SITE CLASS PS DESIGN FLOW 480 L.T.A.R. 0.30 GPD/FT²

Septic Tank: 1000 Gallons; STB 1012 Date 7/29/05

Pump Tank: Gallons; PT Date

Pump Make: Model Serial No.

Nitrification Field: No Fields 1 Square Feet EQ TO 1600 Linear Feet 400

No Lines FIVE Trench Width 36" Max Trench Bottom Depth 36" Gravel Depth N/A

☑ New System ☐ Repair System Type: I, II, (III), IV, V, VI

System Description: 25% REDUCTION, GRAVITY

Repair System Description: 50% REDUCTION, PUMP

Maintenance Agreement Required: ☐ Yes ☑ No

☑ House/Mod. Home No. Bedrooms 4

☐ Mobile Home No. Bathrooms

☐ Business No. Employees

☐ Other


☐ Slab ☐ Crawl Space ☑ Basement w/plumbing ☐ Basement wo/plumbing

Water Supply: ☐ Individual ☑ Public ☐ Community


Comments/Conditions: ① CONTACT HEALTH DEPARTMENT AFTER CLEARING & PRIOR TO INSTALLATION TO FLAG-OUT SYSTEM ② INSTALL 25% REDUCTION SYSTEM ON CONTOUR AS FLAGGED ③ KEEP SYSTEM MINIMUM 50'+ FROM HIGH WATER MARK

Comments/Conditions: Septic Tank Marker Yellow Lot Tile

INITIAL SITE SKETCH

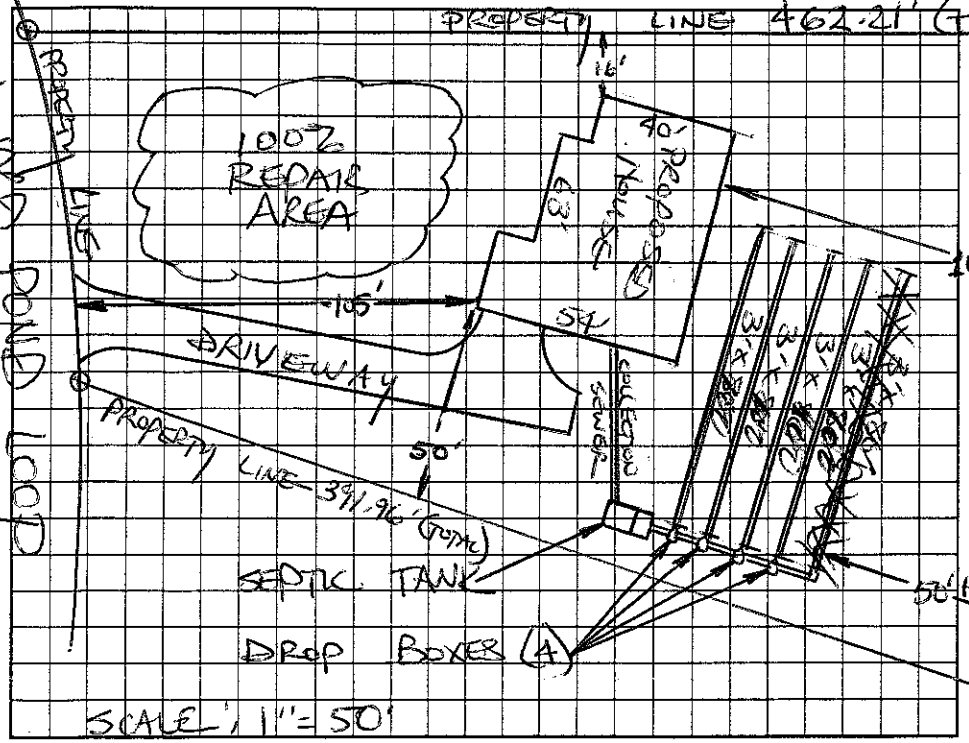

AS BUILT SKETCH

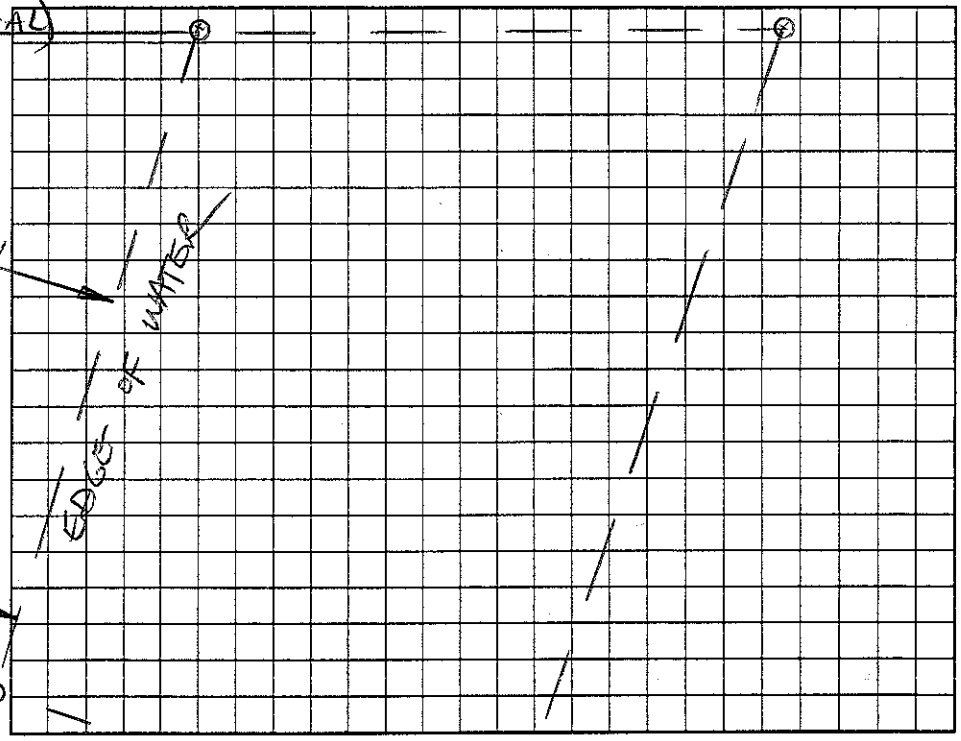

Permit can be suspended or revoked if any false information is supplied toward securing the permit/any unauthorized changes are made to the site/any unauthorized changes are made in the installation of the system. Improvement Permit with plat valid without expiration. Improvement Permit with site plan valid for sixty months. Authorization to Construct is valid for a period equal to that of Improvement Permit – not to exceed sixty months.

Signed: Nancy Sheets date

Improvement Permit by: STEVE HEDRICK date 12-16-04

Authorization to Construct by: STEVE HEDRICK date 12-16-04

Installed by: A-1 Backhoe

Operation Permit by: Kelly Cox ® date 3-10-06

Existing System Inspection by: date

HEALTH DEPT. COPY: WHITE OWNER COPY (FINAL): YELLOW OWNER COPY (INITIAL): PINK