IREDELL COUNTY HEALTH DEPARTMENT

STATESVILLE 704-878-5305 (C1) MOORESVILLE 704-664-5281

IMPROVEMENT PERMIT / AUTHORIZATION TO CONSTRUCT / OPERATION PERMIT / EXISTING SYSTEM INSPECTION

PERMIT# 108546 PIN# 4775-04-6438 DATE 10-21-02

OWNER OR CONTRACTOR McHenry Construction Inc. PHONE: Business 336-367-3608 Home

ADDRESS 4408 PAULS LANE BETHANIA, NC 27011

LOCATION 64E, (C) SAIN, (L) WOODRUG BROOKE WAY, LOT # 31 ON LFT

SUBDIVISION SPRING FOREST BLOCK / SECTION LOT 31 LOT AREA 1.8AC SITE CLASS. PS DESIGN FLOW 360 L.T.A.R. .35

Septic Tank: 1000 Gallons; S/B 1012 Date 2-27-03

Pump Tank: Gallons; P/T Date

Pump Make: Model Serial No.

Nitrification Field: No Fields 4 Square Feet 1028 Linear Feet 342'

No. Lines 3 Trench Width 36" Max Trench Bottom Depth 36" Gravel Depth 12"

[X] New System [ ] Repair System Type: I. II. III. IV. V. VI

System Description: 6 GRAV CONV

Repair System Description: 4 PANEL

Maintenance Agreement Required: [ ] Yes [X] No

[X] House/Mod. Home No. Bedrooms 3

[ ] Mobile Home No. Bathrooms 2

[ ] Business No. Employees

[ ] Other


[X] Slab [ ] Crawl Space [ ] Basement w/plumbing [ ] Basement wo/plumbing

Water Supply: [ ] Individual [X] Public [ ] Community


Comments/Conditions: ① MAINTAIN SETBACKS ② SYSTEM & HOUSE IS ENTIRELY FLAG GOOD OUT ③ FILL & PACK WASHOUTS ④ INSTALL LINES ON CONTOURS.

Comments/Conditions: SEPTIC TANK WITH MARKER INSTALLED USING "TUFFITE" FILTER

INITIAL SITE SKETCH

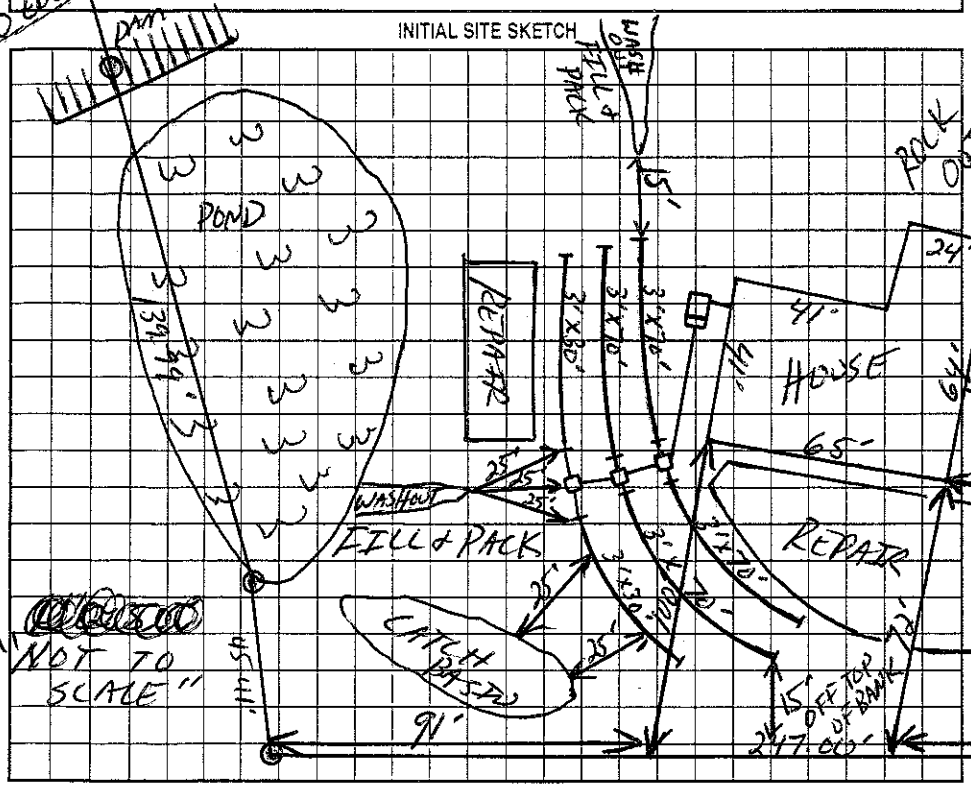

AS BUILT SKETCH

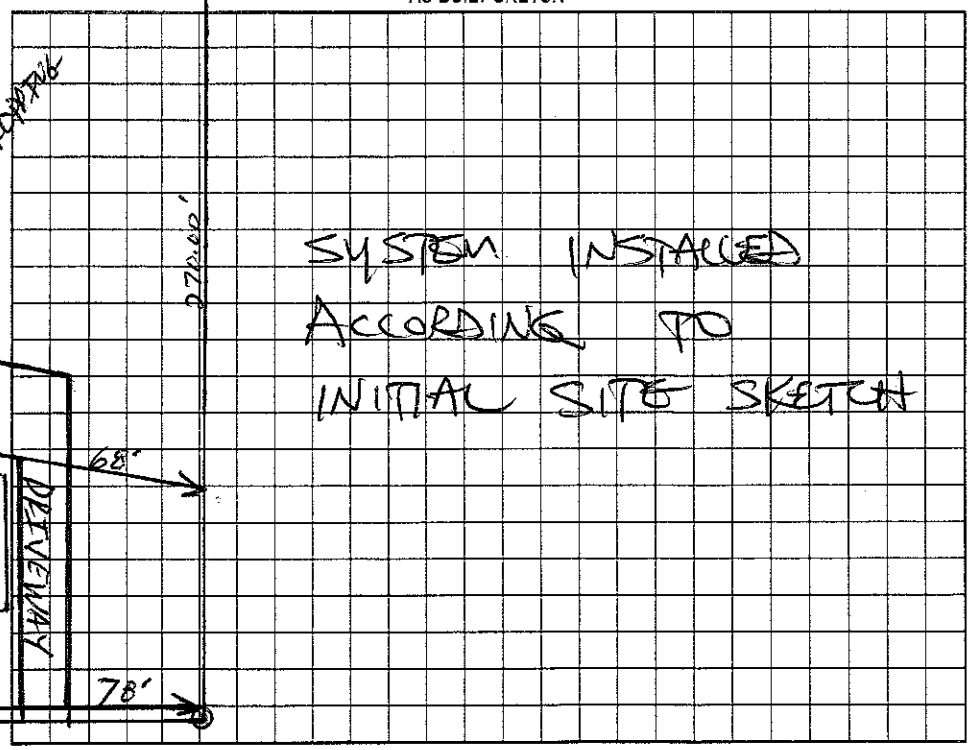

Permit can be suspended or revoked if any false information is supplied toward securing the permit/any unauthorized changes are made to the site/any unauthorized changes are made in the installation of the system. Improvement Permit with plat valid without expiration. Improvement Permit with site plan valid for sixty months. Authorization to Construct is valid for a period equal to that of Improvement Permit – not to exceed sixty months.

Signed: Sylvia McHenry date 10/24/02

Improvement Permit by: date 10-21-02

Authorization to Construct by: date 10-21-02

Installed by: A-1 BACKHOE

Operation Permit by: STEVE HEDRICK date 9-4-03

Existing System Inspection by: date

HEALTH DEPT. COPY: WHITE OWNER COPY (FINAL): YELLOW OWNER COPY (INITIAL): PINK