CI/CI K0267357

IREDELL COUNTY HEALTH DEPARTMENT

STATESVILLE 704-878-5305 MOORESVILLE 704-664-5281

IMPROVEMENT PERMIT / AUTHORIZATION TO CONSTRUCT / OPERATION PERMIT / EXISTING SYSTEM INSPECTION

PERMIT# 104183 PIN# 4775-04-6909 DATE 03/04/02

OWNER OR CONTRACTOR TERRATEK PHONE: Business (CELL) 704-902-0119 Home

ADDRESS 185 HOWARD POND LANE STATESVILLE NC 28625

LOCATION HWY 64 E, (L) SAIN RD, (R) SPRING FORREST (L) HOWARDS POND LOT # 54 ON LEFT

SUBDIVISION SPRING FORREST BLOCK / SECTION ____ LOT 54 LOT AREA 1.2310 AC SITE CLASS. PS DESIGN FLOW 360 L.T.A.R. .3

Septic Tank: 1000 Gallons; STB 794 Date 9-4-02

Pump Tank: 1000 Gallons; PT 27 Date 11-26-02

Pump Make: GOULDS Model GOULDS WE03H Serial No. K0267357

Nitrification Field: No Fields 1 Square Feet 600=1200' Linear Feet 300'

No Lines 4X75' Trench Width 36" Max Trench Bottom Depth 36" Gravel Depth N/A

☒ New System ☐ Repair System Type: I, II, (III), IV, V, VI

System Description: PUMP 25% REDUCTION

Repair System Description: LP PANEL

Maintenance Agreement Required: ☐ Yes ☒ No

☐ Slab ☒ Crawl Space ☐ Basement w/plumbing ☐ Basement wo/plumbing

☒ House/Mod. Home No. Bedrooms 3

☐ Mobile Home No. Bathrooms 2

☐ Business No. Employees ____

☐ Other ____

Water Supply: ☐ Individual ☒ Public ☐ Community


LC 01-09-03

Comments:/Conditions: (1) SYSTEM & HOUSE IS FLAGGED OUT (2) KEEP H2O LINE 10' FROM ANY PART OF SYSTEM (3) 15' SIDE SLOPE SETBACK OFF OF CATCH BASIN & 10' SETBACK BELOW DITCH (4) FILL CATCH


Comments:/Conditions: BASIN, DO NOT CUT DUE TO SYSTEM BEING SO CLOSE TO IT. (5) CALL PRIOR TO INSTALLATION FOR PUMP SIZING

ZABEL FILTER, MARKER, & RISERS, I'D LINES & TANK. NEEDS FLOAT TREE, PRESSURE & ELECTRICAL

INITIAL SITE SKETCH 1" = 50'

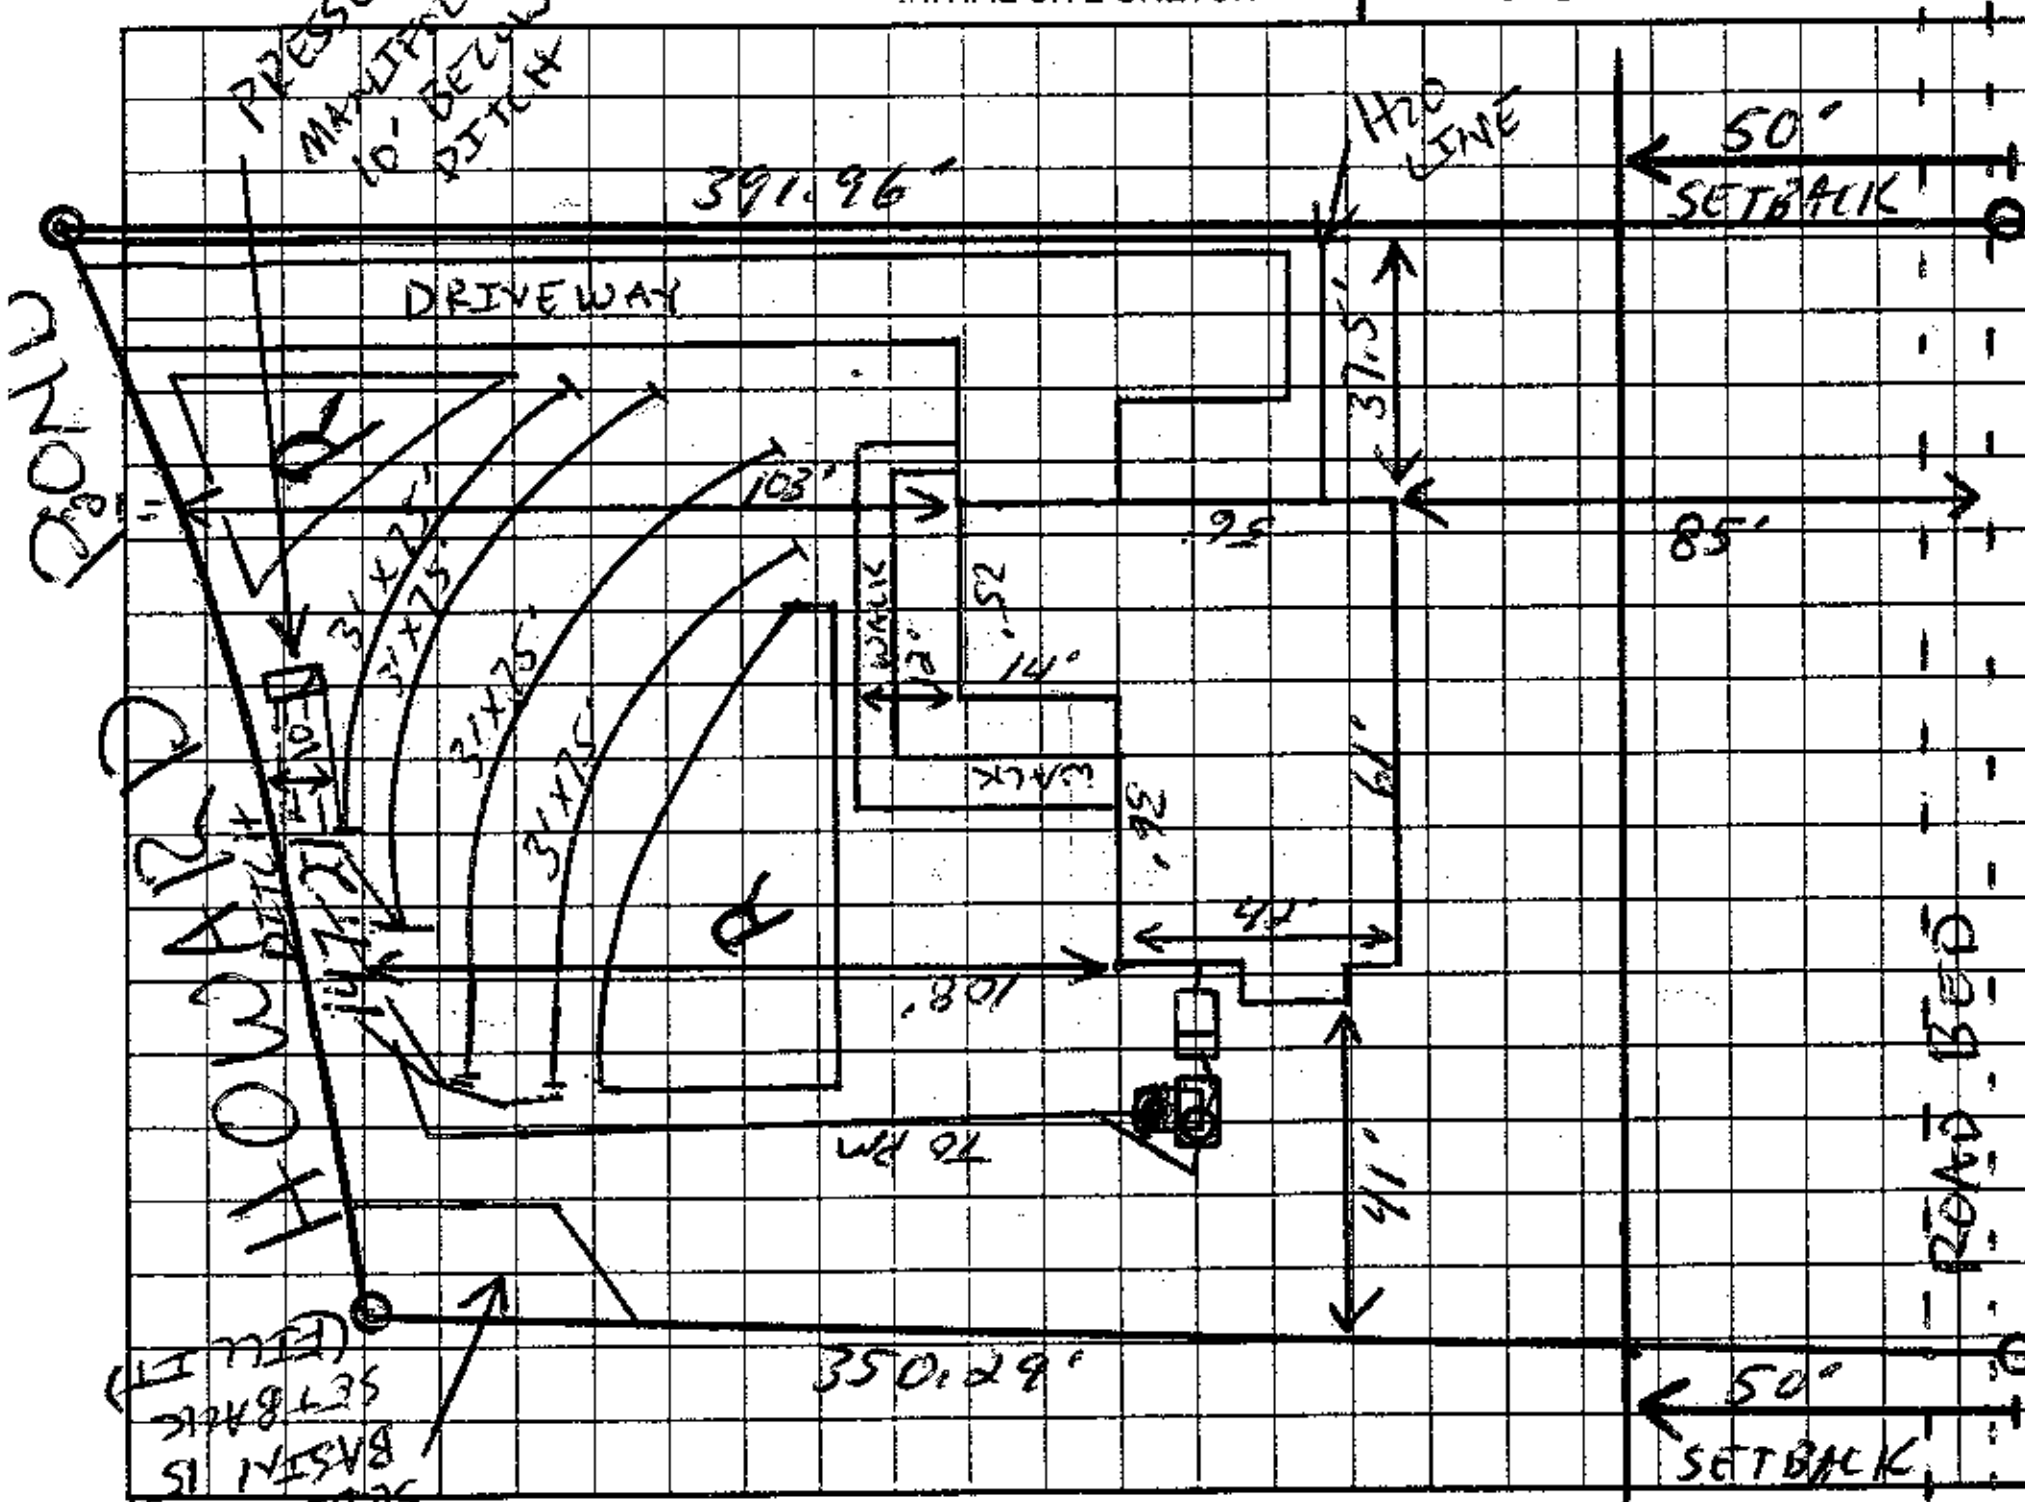

AS BUILT SKETCH

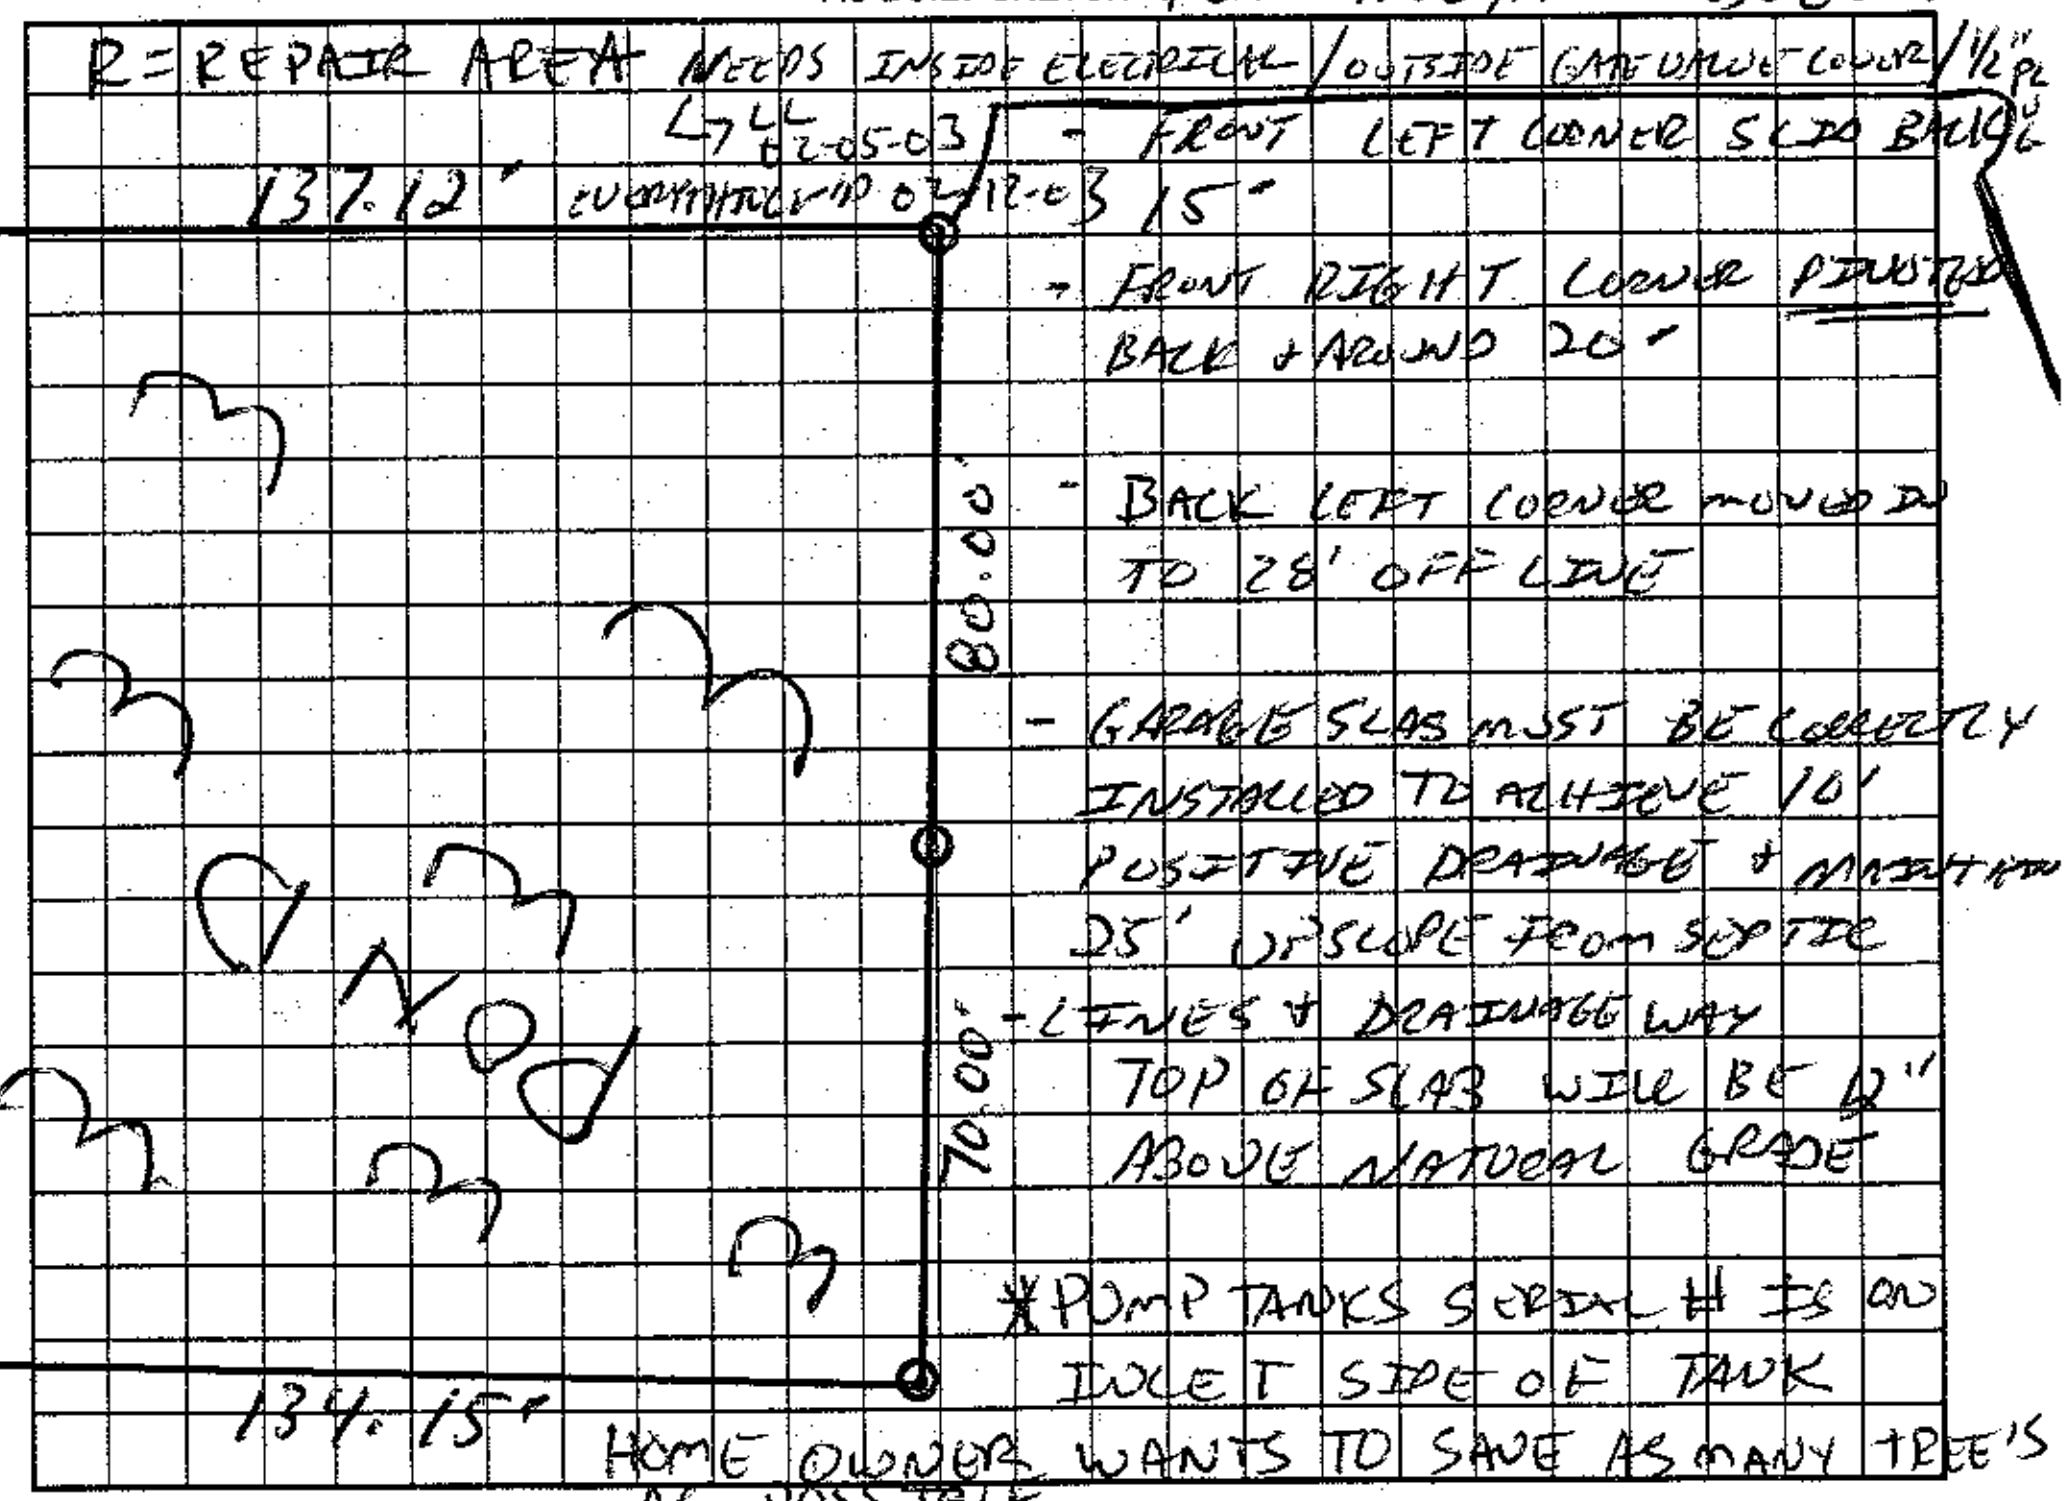

Permit can be suspended or revoked if any false information is supplied toward securing the permit/any unauthorized changes are made to the site/any unauthorized changes are made in the installation of the system. Improvement Permit with plat valid without expiration. Improvement Permit with site plan valid for sixty months. Authorization to Construct is valid for a period equal to that of Improvement Permit – not to exceed sixty months.

Signed: William J. Zubowski date 3/5/02 Installed by: MARTY TUCKER

Improvement Permit by: L. Cook RS date 03-04-02 Operation Permit by: L. Cook RS date 02-12-03

Authorization to Construct by: L. Cook RS date 03-04-02 Existing System Inspection by: ____ date ____

HEALTH DEPT. COPY: WHITE OWNER COPY (FINAL): YELLOW OWNER COPY (INITIAL): PINK