IREDELL COUNTY HEALTH DEPARTMENT

STATESVILLE 704-878-5305 (A) MOORESVILLE 704-664-5281

IMPROVEMENT PERMIT / AUTHORIZATION TO CONSTRUCT / OPERATION PERMIT / EXISTING SYSTEM INSPECTION

PERMIT# 122156 PIN# 4775-04-7157 DATE 7-6-04

OWNER OR CONTRACTOR CHET W. MOORE PHONE: Business 704-871-2383 Home 704-663-7277

ADDRESS 138 KISKADEE DRIVE, MOORESVILLE, NC 28117

LOCATION US64 EAST, TL SAIN ROAD, TL WINDING BROOK WAY, LOT #17 ON LEFT AT BRANCH

SUBDIVISION SPRING FOREST BLOCK / SECTION ____ LOT 17 LOT AREA 1.2075 ACRES SITE CLASS. PS I DESIGN FLOW 480 L.T.A.R. 0.30 GPD/FT²

Septic Tank: 1000 Gallons; STB 825 Date 2-6-05
Pump Tank: ____ Gallons; PT ____ Date ____
Pump Make: ____ Model ____ Serial No. ____
Nitrification Field: No Fields 1 Square Feet 1600 Linear Feet 400
No Lines FIVE Trench Width 36" Max Trench Bottom Depth 36" Gravel Depth N/A

☑ New System ☐ Repair System Type: I, II, III, IV, V, VI
System Description: 25% REDUCTION, GRAVITY
Repair System Description: 50% REDUCTION, LOW-PRESSURE
Maintenance Agreement Required: ☐ Yes ☒ No

☑ House/Mod. Home ☐ Mobile Home ☐ Business ☐ Other
No. Bedrooms 4 No. Bathrooms 4 No. Employees ____


Water Supply: ☐ Individual ☒ Public ☐ Community

☐ Slab ☒ Crawl Space ☐ Basement w/plumbing ☐ Basement wo/plumbing

Comments/Conditions: ① INSTALL SUBSURFACE DRAINAGE AT LOCATION SHOWN BEGINNING 48" DEEP ② INSTALL 25% REDUCTION SYSTEM

Comments/Conditions: SYSTEM INSTALLED USING SEPTIC TANK MARKER WITH "POLY LOK" FILTER

INITIAL SITE SKETCH

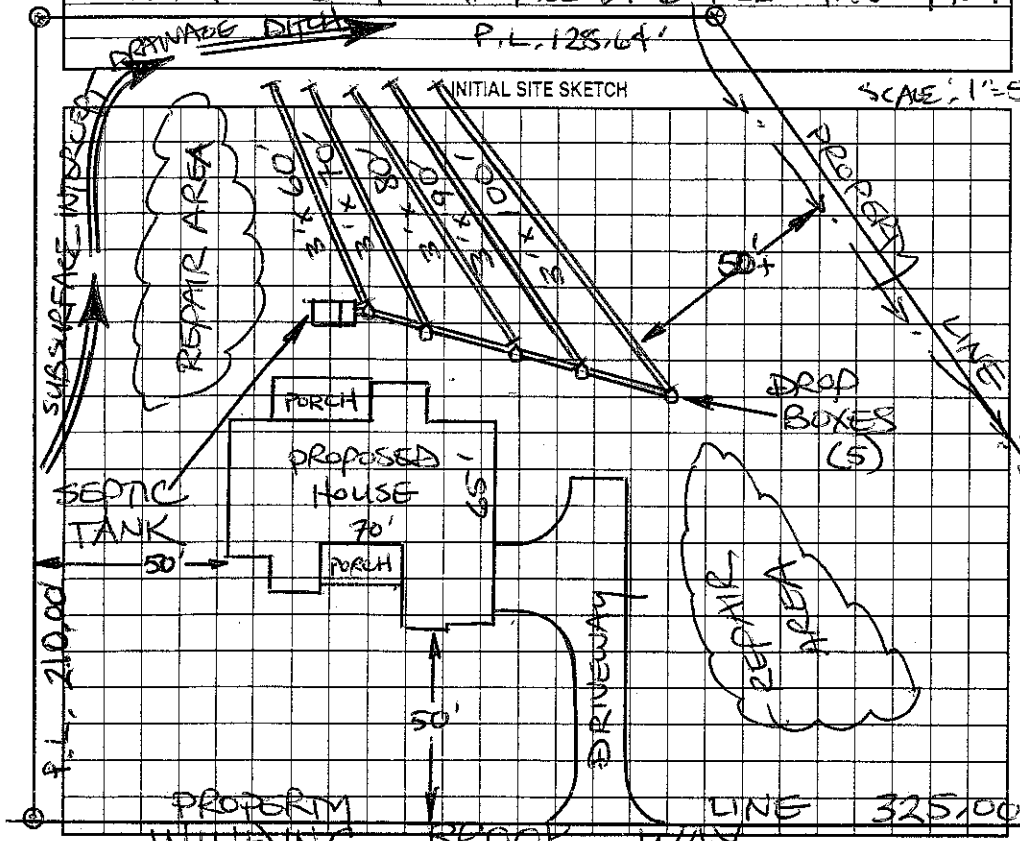

AS BUILT SKETCH

SYSTEM INSTALLED ACCORDING TO INITIAL SITE SKETCH

Permit can be suspended or revoked if any false information is supplied toward securing the permit/any unauthorized changes are made to the site/any unauthorized changes are made in the installation of the system. Improvement Permit with plan valid without expiration. Improvement Permit with site plan valid for sixty months. Authorization to Construct is valid for a period equal to that of Improvement Permit – not to exceed sixty months.

Signed: Chet W. Moore date 7/6/04

Improvement Permit by: STEVE HEDRICK date 7-6-04

Authorization to Construct by: STEVE HEDRICK date 7-6-04

Installed by: ROWAN SEPTIC

Operation Permit by: STEVE HEDRICK date 8-15-05

Existing System Inspection by: ____ date ____

HEALTH DEPT. COPY: WHITE OWNER COPY (FINAL): YELLOW OWNER COPY (INITIAL): PINK