IREDELL COUNTY HEALTH DEPARTMENT

STATESVILLE 704-878-5305 (C) MOORESVILLE 704-664-5281

IMPROVEMENT PERMIT / AUTHORIZATION TO CONSTRUCT / OPERATION PERMIT / EXISTING SYSTEM INSPECTION

PERMIT# 114838 PIN# 4775-04-9145 DATE 8-13-03

OWNER OR CONTRACTOR [redacted] (CHRIS SHAW) PHONE: Business 704-902-0086 Home

ADDRESS PO BOX 1061 TROUTMAN, NC 28166

LOCATION 64 EAST, © SAIN, (L) WINDING BROOKE, © @ lot # 16

SUBDIVISION SPRING FOREST BLOCK / SECTION LOT 16 LOT AREA .627 SITE CLASS PS DESIGN FLOW 360 L.T.A.R. .25

Septic Tank: 1000 Gallons; STB 1000 Date 12-17-03
Pump Tank: Gallons; PT Date
Pump Make: Model Serial No.
Nitrification Field: No Fields 1 Square Feet 1440' Linear Feet 360'
No Lines 5 Trench Width 36" Max Trench Bottom Depth 30"-36" Gravel Depth N/A

☒ New System ☐ Repair System Type: I, II, III, IV, V, VI
System Description: GRAV 25% REDUCT
Repair System Description: LP PAPER
Maintenance Agreement Required: ☐ Yes ☒ No


☒ House/Mod. Home No. Bedrooms 3
☐ Mobile Home No. Bathrooms 3½
☐ Business No. Employees
☐ Other
☐ Slab ☒ Crawl Space ☐ Basement w/plumbing ☐ Basement wo/plumbing

Water Supply: ☐ Individual ☒ Public ☐ Community


Comments:/Conditions: ① INSTALL LINES ON CONTOURS ② MAINTAIN SETBACKS ③ NOTE TRENCH BOTTOM DEPTH ④ INSTALL LINES IN NATURAL SOIL, FIRST ≈ 20' OF EACH LINE HAS 8-12" OF FILL DIRT

Comments:/Conditions: ON LOT. ① SEPTIC TANK INSTALLED USING MARKER AND "TUFTITE" FILTER ② SYSTEM INSTALLED WITH PRIOR H.D. APPROVAL AS SHOWN USING "EEE-ZZZ-Flow"

INITIAL SITE SKETCH

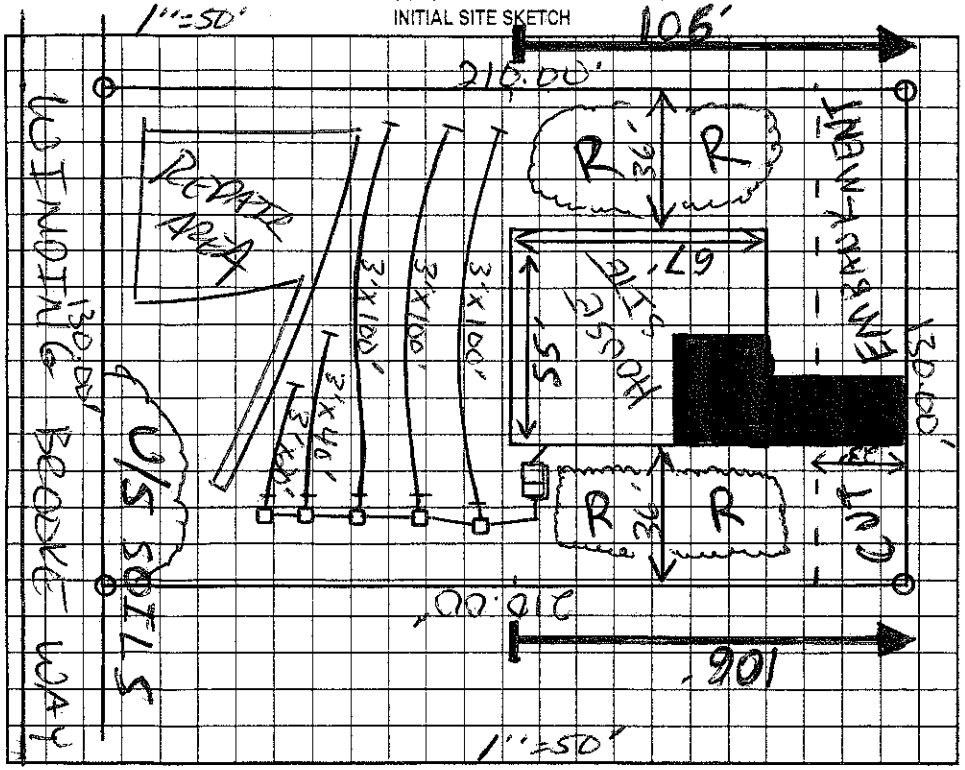

AS BUILT SKETCH

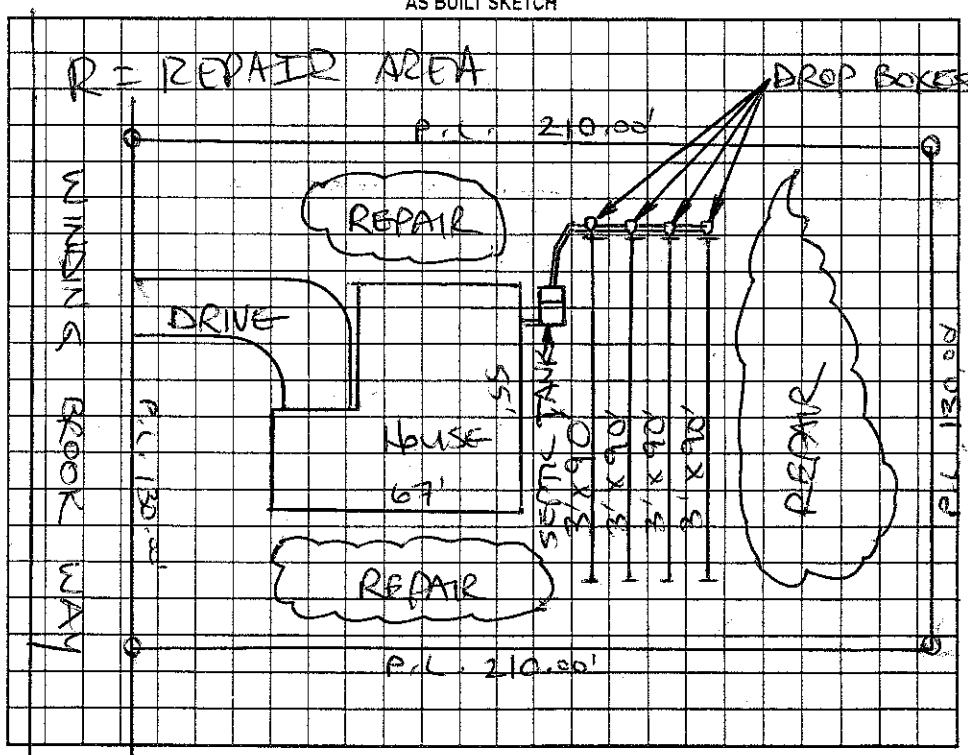

Permit can be suspended or revoked if any false information is supplied toward securing the permit/any unauthorized changes are made to the site/any unauthorized changes are made in the installation of the system. Improvement Permit with plat valid without expiration. Improvement Permit with site plan valid for sixty months. Authorization to Construct is valid for a period equal to that of Improvement Permit – not to exceed sixty months.

Signed: [redacted] date 8-14-03 Installed by: JAMES HUDLER

Improvement Permit by: [redacted] date 8-13-03 Operation Permit by: STEVE HEDRICK date 2-20-04

Authorization to Construct by: [redacted] date 8-13-03 Existing System Inspection by: date

HEALTH DEPT. COPY: WHITE OWNER COPY (FINAL): YELLOW OWNER COPY (INITIAL): PINK