IREDELL COUNTY HEALTH DEPARTMENT

STATESVILLE 704-878-5305 MOORESVILLE 704-664-5281

IMPROVEMENT PERMIT / AUTHORIZATION TO CONSTRUCT / OPERATION PERMIT / EXISTING SYSTEM INSPECTION

PERMIT# 107226 PIN# 4775-04-9482 DATE 07-24-02

OWNER OR CONTRACTOR ROBERT HALL PHONE: Business Home 704-838-0486

ADDRESS 137 SUZUKI DR TROUTMAN, NC 28166

LOCATION 64 E, (R) SAIN, (L) WINDING BROOKE, LOT # 33 ON RT

SUBDIVISION SPRING FOREST BLOCK / SECTION LOT 33 LOT AREA .8043 AC SITE CLASS PS DESIGN FLOW 360 L.T.A.R. .13

Septic Tank: 1000 Gallons; STB 1012 Date 4-3-05
Pump Tank: Gallons; PT Date
Pump Make: Model Serial No.
Nitrification Field: No. Fields 1 Square Feet EQUITOU Linear Feet 200'
No. Lines 6X34' Trench Width 24" Max Trench Bottom Depth 36" Gravel Depth N/A

[X] New System [ ] Repair System Type: I, II, (III), IV, V, VI
System Description: GRAV 5040 1260
Repair System Description: LP PANEL
Maintenance Agreement Required: [ ] Yes [X] No

[X] House/Mod. Home No. Bedrooms 3
[ ] Mobile Home No. Bathrooms 2
[ ] Business No. Employees
[ ] Other


Water Supply: [ ] Individual [X] Public [ ] Community

[ ] Slab [X] Crawl Space [ ] Basement w/plumbing [ ] Basement wo/plumbing

Comments:/Conditions: (1) INSTALL LINES ON CONTOURS (2) MAINTAIN SETBACKS (3) HOUSE SITE / STUB OUT NEEDS TO BE ABOVE NATURAL GRADE DO TO LANDSCAPE POSITION. THIS WILL REQUIRE BACKFILLING THE FRONT

Comments:/Conditions: OF THE HOUSE.
TUFFTITE Filter & MARKER

INITIAL SITE SKETCH 1"=50'

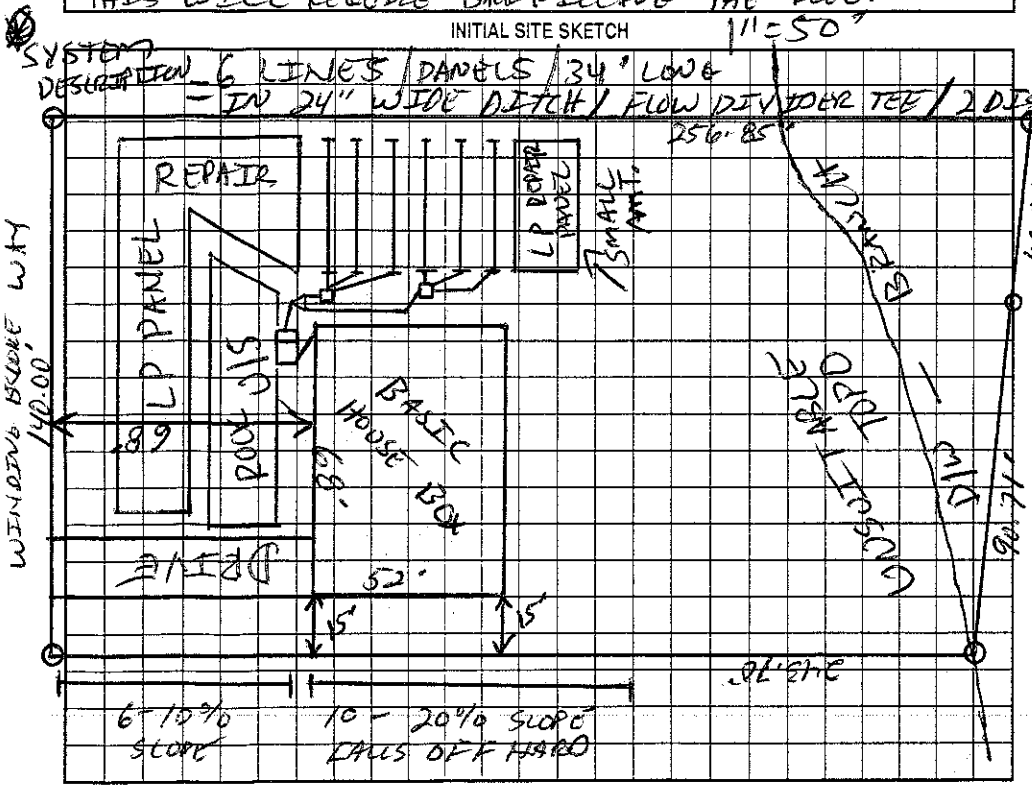

AS BUILT SKETCH

SYSTEM INSTALLED AS DRAWN 10' OFF MARKED P/L

Permit can be suspended or revoked if any false information is supplied toward securing the permit/any unauthorized changes are made to the site/any unauthorized changes are made in the installation of the system. Improvement Permit with plat valid without expiration. Improvement Permit with site plan valid for sixty months. Authorization to Construct is valid for a period equal to that of Improvement Permit – not to exceed sixty months.

Signed: Robert B. Hall date 7-24-02

Improvement Permit by: [signature] date 7-24-02

Authorization to Construct by: [signature] date 7-24-02

Installed by: A-1 BACKHOE

Operation Permit by: [signature] date 10-31-05

Existing System Inspection by: date

HEALTH DEPT. COPY: WHITE OWNER COPY (FINAL): YELLOW OWNER COPY (INITIAL): PINK