IREDELL COUNTY HEALTH DEPARTMENT

STATESVILLE 704-878-5305 (CI) MOORESVILLE 704-664-5281

IMPROVEMENT PERMIT / AUTHORIZATION TO CONSTRUCT / OPERATION PERMIT / EXISTING SYSTEM INSPECTION

PERMIT# 103708 PIN# 4775-14-0974.51 DATE 12-21-01

OWNER OR CONTRACTOR KENNETH DEFEO PHONE: Business _____ Home 704-878-6167

ADDRESS 541 HEDRICK DR STATESVILLE NC 28677

LOCATION HWY 64 E, (L) SAIN, (L) ON 2nd RD ON LEFT, (L) OF FIRST RD ON RT, LOT 51 ON LEFT

SUBDIVISION SPRING FOREST BLOCK / SECTION _____ LOT 51 LOT AREA 47,077 / 1.08AC SITE CLASS PS DESIGN FLOW 360 L.T.A.R. 125

Septic Tank: 1000 Gallons; STB 1012 Date 5-19-02

Pump Tank: _____ Gallons; PT _____ Date _____

Pump Make: _____ Model _____ Serial No _____

Nitrification Field: No Fields 1 Square Feet EQ=1440' Linear Feet 360'

No Lines 5 Trench Width 36" Max Trench Bottom Depth 24" Gravel Depth N/A

[X] New System [ ] Repair System Type: I, II, (III), IV, V, VI

System Description: GRAV 25%10 REC

Repair System Description: LP PANEL

Maintenance Agreement Required: [ ] Yes [X] No

[X] House/Mod. Home No. Bedrooms 3

[ ] Mobile Home No. Bathrooms 3

[ ] Business No. Employees ____

[ ] Other _____


[ ] Slab [X] Crawl Space [ ] Basement w/plumbing [ ] Basement wo/plumbing

Water Supply: [ ] Individual [X] Public [ ] Community

Comments:/Conditions: (1) KEEP ENTIRE SYSTEM 10' DOWNSLOPE OF FRENCH DRAIN (2) FILL & PACK GULLY & LINES CAN GO UP TO 5' OF GULLY INSTEAD OF 15' (3) SYSTEM IS FLAGGED OUT & KEEP HOUSE AS DRAWN AWAY FROM H DRAIN

Comments:/Conditions: (4) INSTALL LINES ON CONTOURS & MAINTAIN SETBACKS (5) INSTALL FRENCH DRAIN 12" DEEPER THAN LINES. POLYLOK FILTER & RISERS

INITIAL SITE SKETCH "NOT TO SCALE"

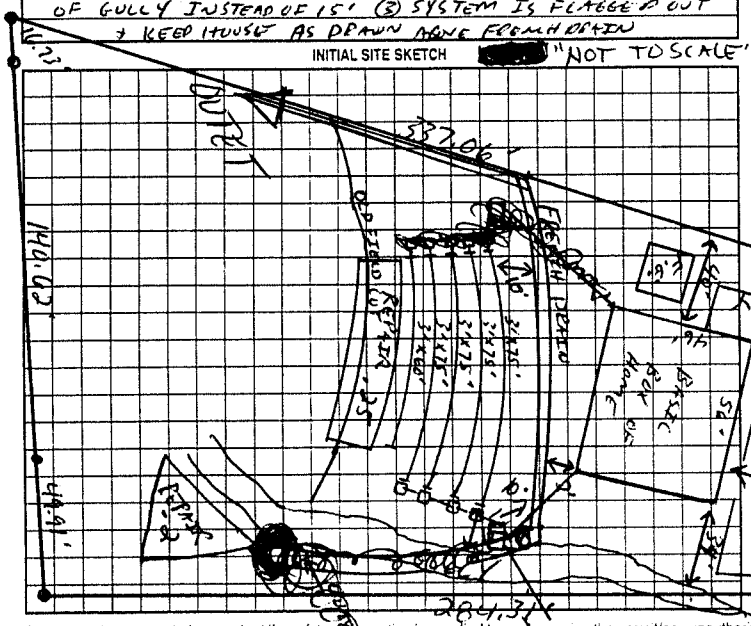

AS BUILT SKETCH

TANK CHANGED TO ORANGE SIDE OF HOUSE AS DRAWN & FRENCH DRAIN CHANGED ALSO. CC 7-31-02

FIRST BOX WAS DIST BOX W/ SPEED LEVELER FED LINE A DROP BOX. BTS OF LINES WAS DROP BOXES.

Permit can be suspended or revoked if any false information is supplied toward securing the permit/any unauthorized changes are made to the site/any unauthorized changes are made in the installation of the system. Improvement Permit with plat valid without expiration/Improvement Permit with site plan valid for sixty months. Authorization to Construct is valid for a period equal to that of Improvement Permit – not to exceed sixty months.

Signed: _____ date 12-27-01 Installed by: YOUNTZ GRADING

Improvement Permit by: _____ date 12-21-01 Operation Permit by: _____ date 7-31-02

Authorization to Construct by: _____ date 12-21-01 Existing System Inspection by: _____ date _____

HEALTH DEPT. COPY WHITE OWNER COPY (FINAL) YELLOW OWNER COPY (INITIAL): PINK