IREDELL COUNTY HEALTH DEPARTMENT

STATESVILLE 704-878-5305 MOORESVILLE 704-664-5281

CI / CF

IMPROVEMENT PERMIT / AUTHORIZATION TO CONSTRUCT / OPERATION PERMIT / EXISTING SYSTEM INSPECTION

PERMIT# 106494 PIN# 4775-05-~~8350~~ 5210 DATE 06-10-02

OWNER OR CONTRACTOR LINDA TRAN PHONE: Business _____ Home 704-871-1877

ADDRESS 106 SEVEN SPRINGS LOOP STATESVILLE, NC 28625

LOCATION ~~E~~ HWY 64, (D) SAIN, (L) SPRING FORREST, (D) 2ND HOWARD POND, ~~[illegible]~~ ON RT

SUBDIVISION SPRING FORREST BLOCK / SECTION _____ LOT 55/56 LOT AREA 2.42 AC SITE CLASS. PS DESIGN FLOW 480 L.T.A.R. .25

Septic Tank: 1000 Gallons; STB 1012 Date 6-30-02
Pump Tank: 1000 Gallons; PT 17 Date 7-30-02
Pump Make: GOULDS Model WE05 12H1T Serial No. E025/557
Nitrification Field: No Fields 1 Square Feet ED=1920 Linear Feet 480'
No Lines 6 x 80' Trench Width 36" Max Trench Bottom Depth 36" Gravel Depth N/A

[X] New System [ ] Repair System Type: I, II, (III), IV, V, VI
System Description: PUMP 2540 R80
Repair System Description: LP PANEL
Maintenance Agreement Required: [ ] Yes [X] No


[X] House/Mod. Home No. Bedrooms 4
[ ] Mobile Home No. Bathrooms 4
[ ] Business No. Employees _____
[ ] Other _____
[ ] Slab [ ] Crawl Space [X] Basement w/plumbing [ ] Basement wo/plumbing

Water Supply: [ ] Individual [X] Public [ ] Community


Comments/Conditions: (1) INSTALL SURFACE DITCH ABOVE FRENCH DRAIN TO CATCH BASIN & FROM CATCH BASIN INSTALL SOLID DRAIN PIPE DOWN P/L (2) KEEP FRENCH DRAIN AS CLOSE TO P/L BUT BELOW SURFACE DITCH &

Comments/Conditions: RUN TO DAY LIGHT DOWN P/L. (3) INSTALL FRENCH DRAIN 12" DEEPER THAN TRENCH BOTTOM DEPTH (4) USE PRESSURE MANIFOLD & MOUNTAIN SETBACKS (5) CALL PRIOR TO INSTALLATION FOR PUMP SIZING.

INITIAL SITE SKETCH

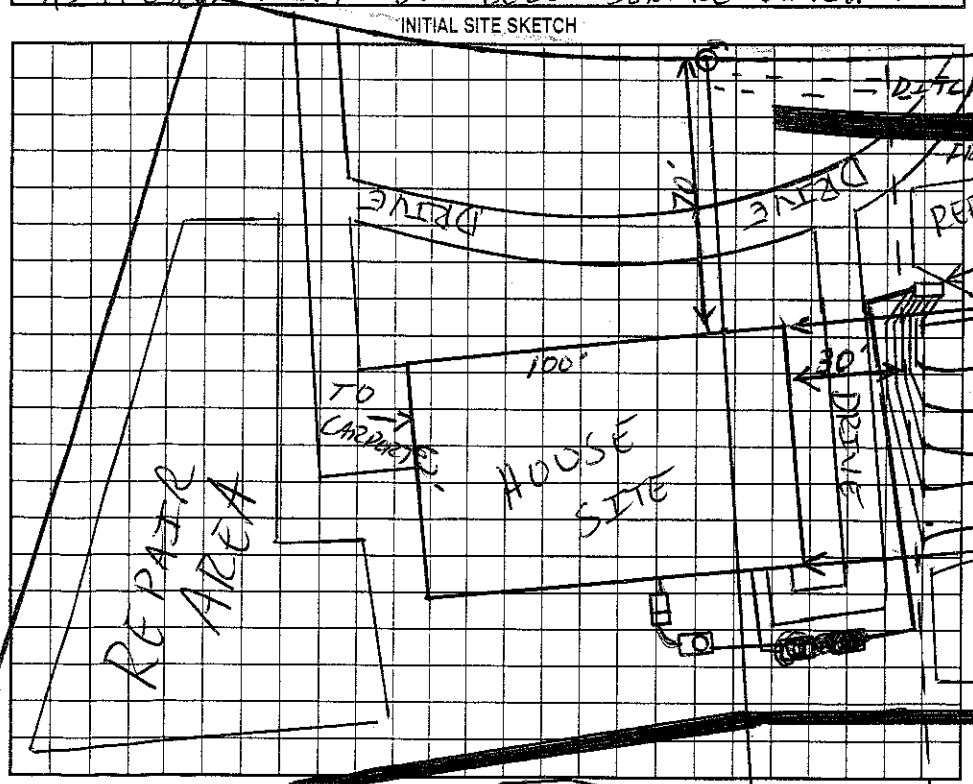

AS BUILT SKETCH

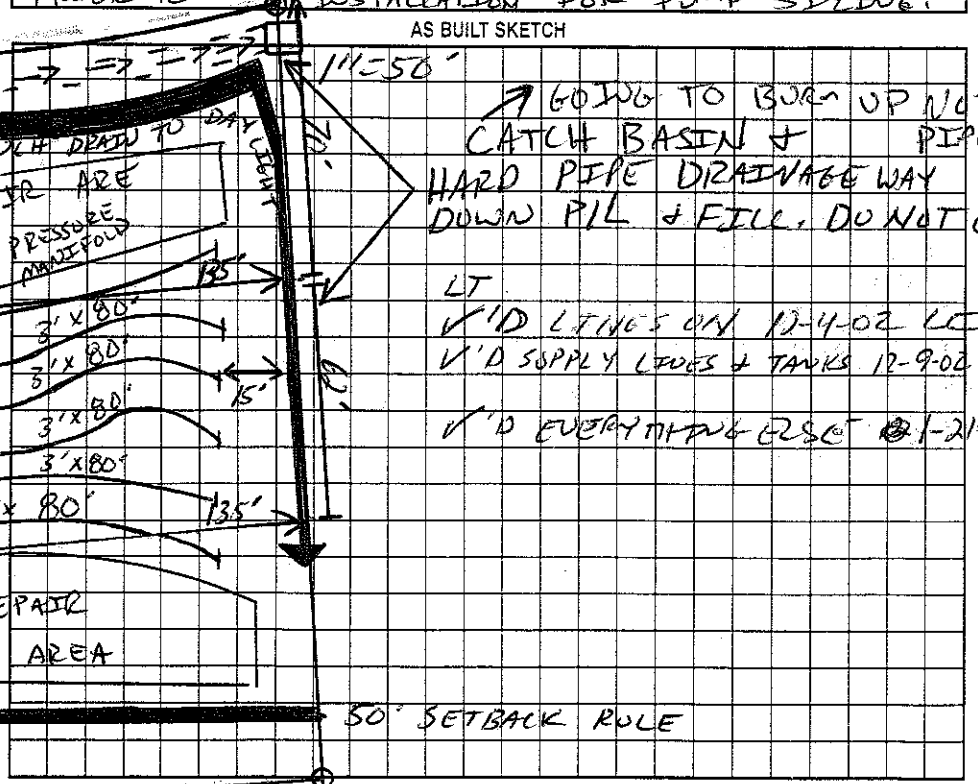

Permit can be suspended or revoked if any false information is supplied toward securing the permit/any unauthorized changes are made to the site/any unauthorized changes are made in the installation of the system. Improvement Permit with plan valid without expiration. Improvement Permit with site plan valid for sixty months. Authorization to Construct is valid for a period equal to that of Improvement Permit – not to exceed sixty months.

Signed: _____ date _____ Installed by: YOUNTZ GRADING

Improvement Permit by: _____ date _____ Operation Permit by: _____ date 01-21-03

Authorization to Construct by: _____ date 06-10-02 Existing System Inspection by: _____ date _____

HEALTH DEPT. COPY: WHITE OWNER COPY (FINAL): YELLOW OWNER COPY (INITIAL): PINK