IREDELL COUNTY HEALTH DEPARTMENT

STATESVILLE 704-878-5305 MOORESVILLE 704-664-5281

IMPROVEMENT PERMIT / AUTHORIZATION TO CONSTRUCT / OPERATION PERMIT / EXISTING SYSTEM INSPECTION

PERMIT# 094102 PIN# 4775 14 0974 PT DATE 02/15/01

OWNER OR CONTRACTOR TODD ELLIS BLDRS PHONE: Business 872-6633 Home

ADDRESS 315 SEVEN SPRINGS LP, STATESVILLE, NC 28625

LOCATION 64E, L SAINT RD, L SPRING FORREST

SUBDIVISION SPRING FORREST BLOCK / SECTION LOT 85 LOT AREA 0.7 ACRES SITE CLASS PS DESIGN FLOW 360 L.T.A.R. .35

Septic Tank: 1000 Gallons; STB 1012 Date 1-15-01
Pump Tank: Gallons; PT Date
Pump Make: Model Serial No
Nitrification Field: No Fields 1 Square Feet 1029 Linear Feet 343
No Lines 5 Trench Width 36" Max Trench Bottom Depth 30"

X New System ☐ Repair System Type: I (II) III. IV. V. VI
System Description: CONV GRAV
Repair System Description: PUMP/PANEL
Maintenance Agreement Required: ☐ Yes X No

X House/Mod. Home No. Bedrooms 3
☐ Mobile Home No. Bathrooms 2½
☐ Business No. Employees
☐ Other


Gravel Depth 12" ☐ Slab X Crawl Space ☐ Basement w/plumbing ☐ Basement wo/plumbing

Water Supply: ☐ Individual X Public ☐ Community

Comments/Conditions: (1) INSTALL LINES ON CONTOUR (2) KEEP SYSTEM 5' off house & 10' off property lines (3) Use 5 DROP BOXES

Comments/Conditions: POLYLOK FILTER & MARKER
TANK & FIRST LINE CHECKED - INSTALLED DURING WET CONDITIONS
LAST 4 LINES CHECKED IN DRY, HOT WEATHER, OK!

INITIAL SITE SKETCH 1"=50'

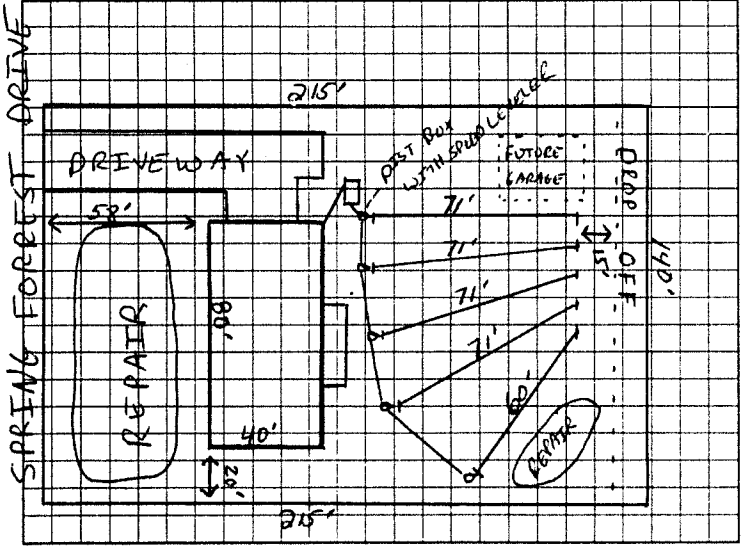

AS BUILT SKETCH

INSTALLED AS SHOWN

Permit can be suspended or revoked if any false information is supplied toward securing the permit/any unauthorized changes are made to the site any unauthorized changes are made in the installation of the system. Improvement Permit with plat valid without expiration. Improvement Permit with site plan valid for sixty months. Authorization to Construct is valid for a period equal to that of Improvement Permit – not to exceed sixty months.

Signed: J. Todd Ellis date 02/15/01 Installed by: DAVID YOUNTZ

Improvement Permit by: Jim Cook RSI date 02/15/01 Operation Permit by: Jim Cook RS date 8-6-01

Authorization to Construct by: Jim Cook RSI date 02/15/01 Existing System Inspection by: date

HEALTH DEPT COPY: WHITE OWNER COPY (FINAL): YELLOW OWNER COPY (INITIAL): PINK